
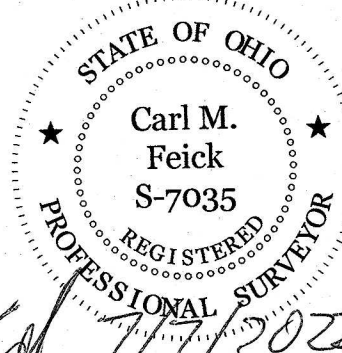
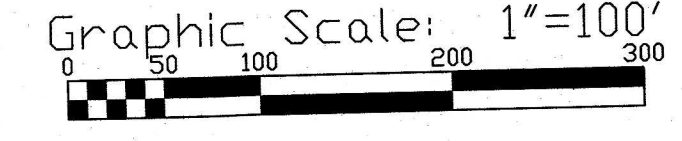


Racke Pointe Villas Condominium
 Plat Volume 51 pages 62 - 66
 Plat Volume 52 pages 51 - 58
 Plat Volume 54 pages 24 - 29
 Plat Volume 56 pages 36 - 43

Legend
 Centerline
 Setback line
 Edge of water top of bank 577.00
 easement line
 Limited Common Area
 • 1/2" Iron pin found in concrete
 • 5/8" Iron pin set

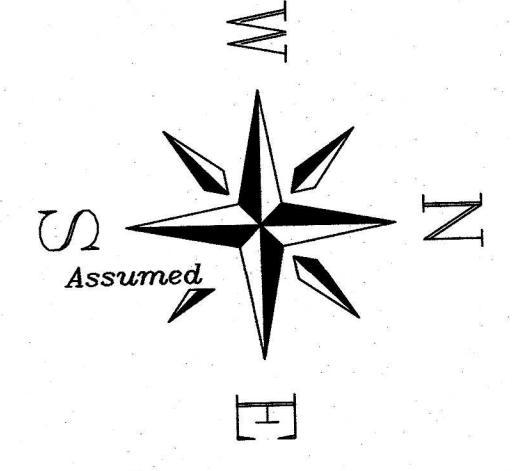

Certification
 I hereby certify that this drawing reflects the location of improvements and recorded easement to the best of my knowledge and belief.

Carl M. Feick
 Carl M. Feick P.S. 7035


Ottawa County Recorder
 # ~~20220519464~~ 219464
 Filed for Record this 26 Day of July 2022
 at 12:18 pm #145.20
 Recorded this 26 Day of July
 in Plat Book 74 pages 37-38
Walter J. Brown

Carl M Feick P.E. P.S.
 712 Bardwell Road
 Castalia, Ohio 44824
 419-656-3016 CFeick@compuserve.com

Created 07/06/2022

Bay View Villas Condominium,
 Being part of lot 53A of Harbor Bay Estates Plat 5, PV 64 P 17 & 18
 Section 4 lot 21, Danbury Township, Ottawa County, Ohio
 Owner: Marblehead Estates & Yacht Club, Ltd. 118 W South Boundary, Perrysburg, Ohio 43551
 419-873-8052

VOL 74 PG 38 Reserve D
 Harbor Bay Estates
 Plat Volume 58 Page

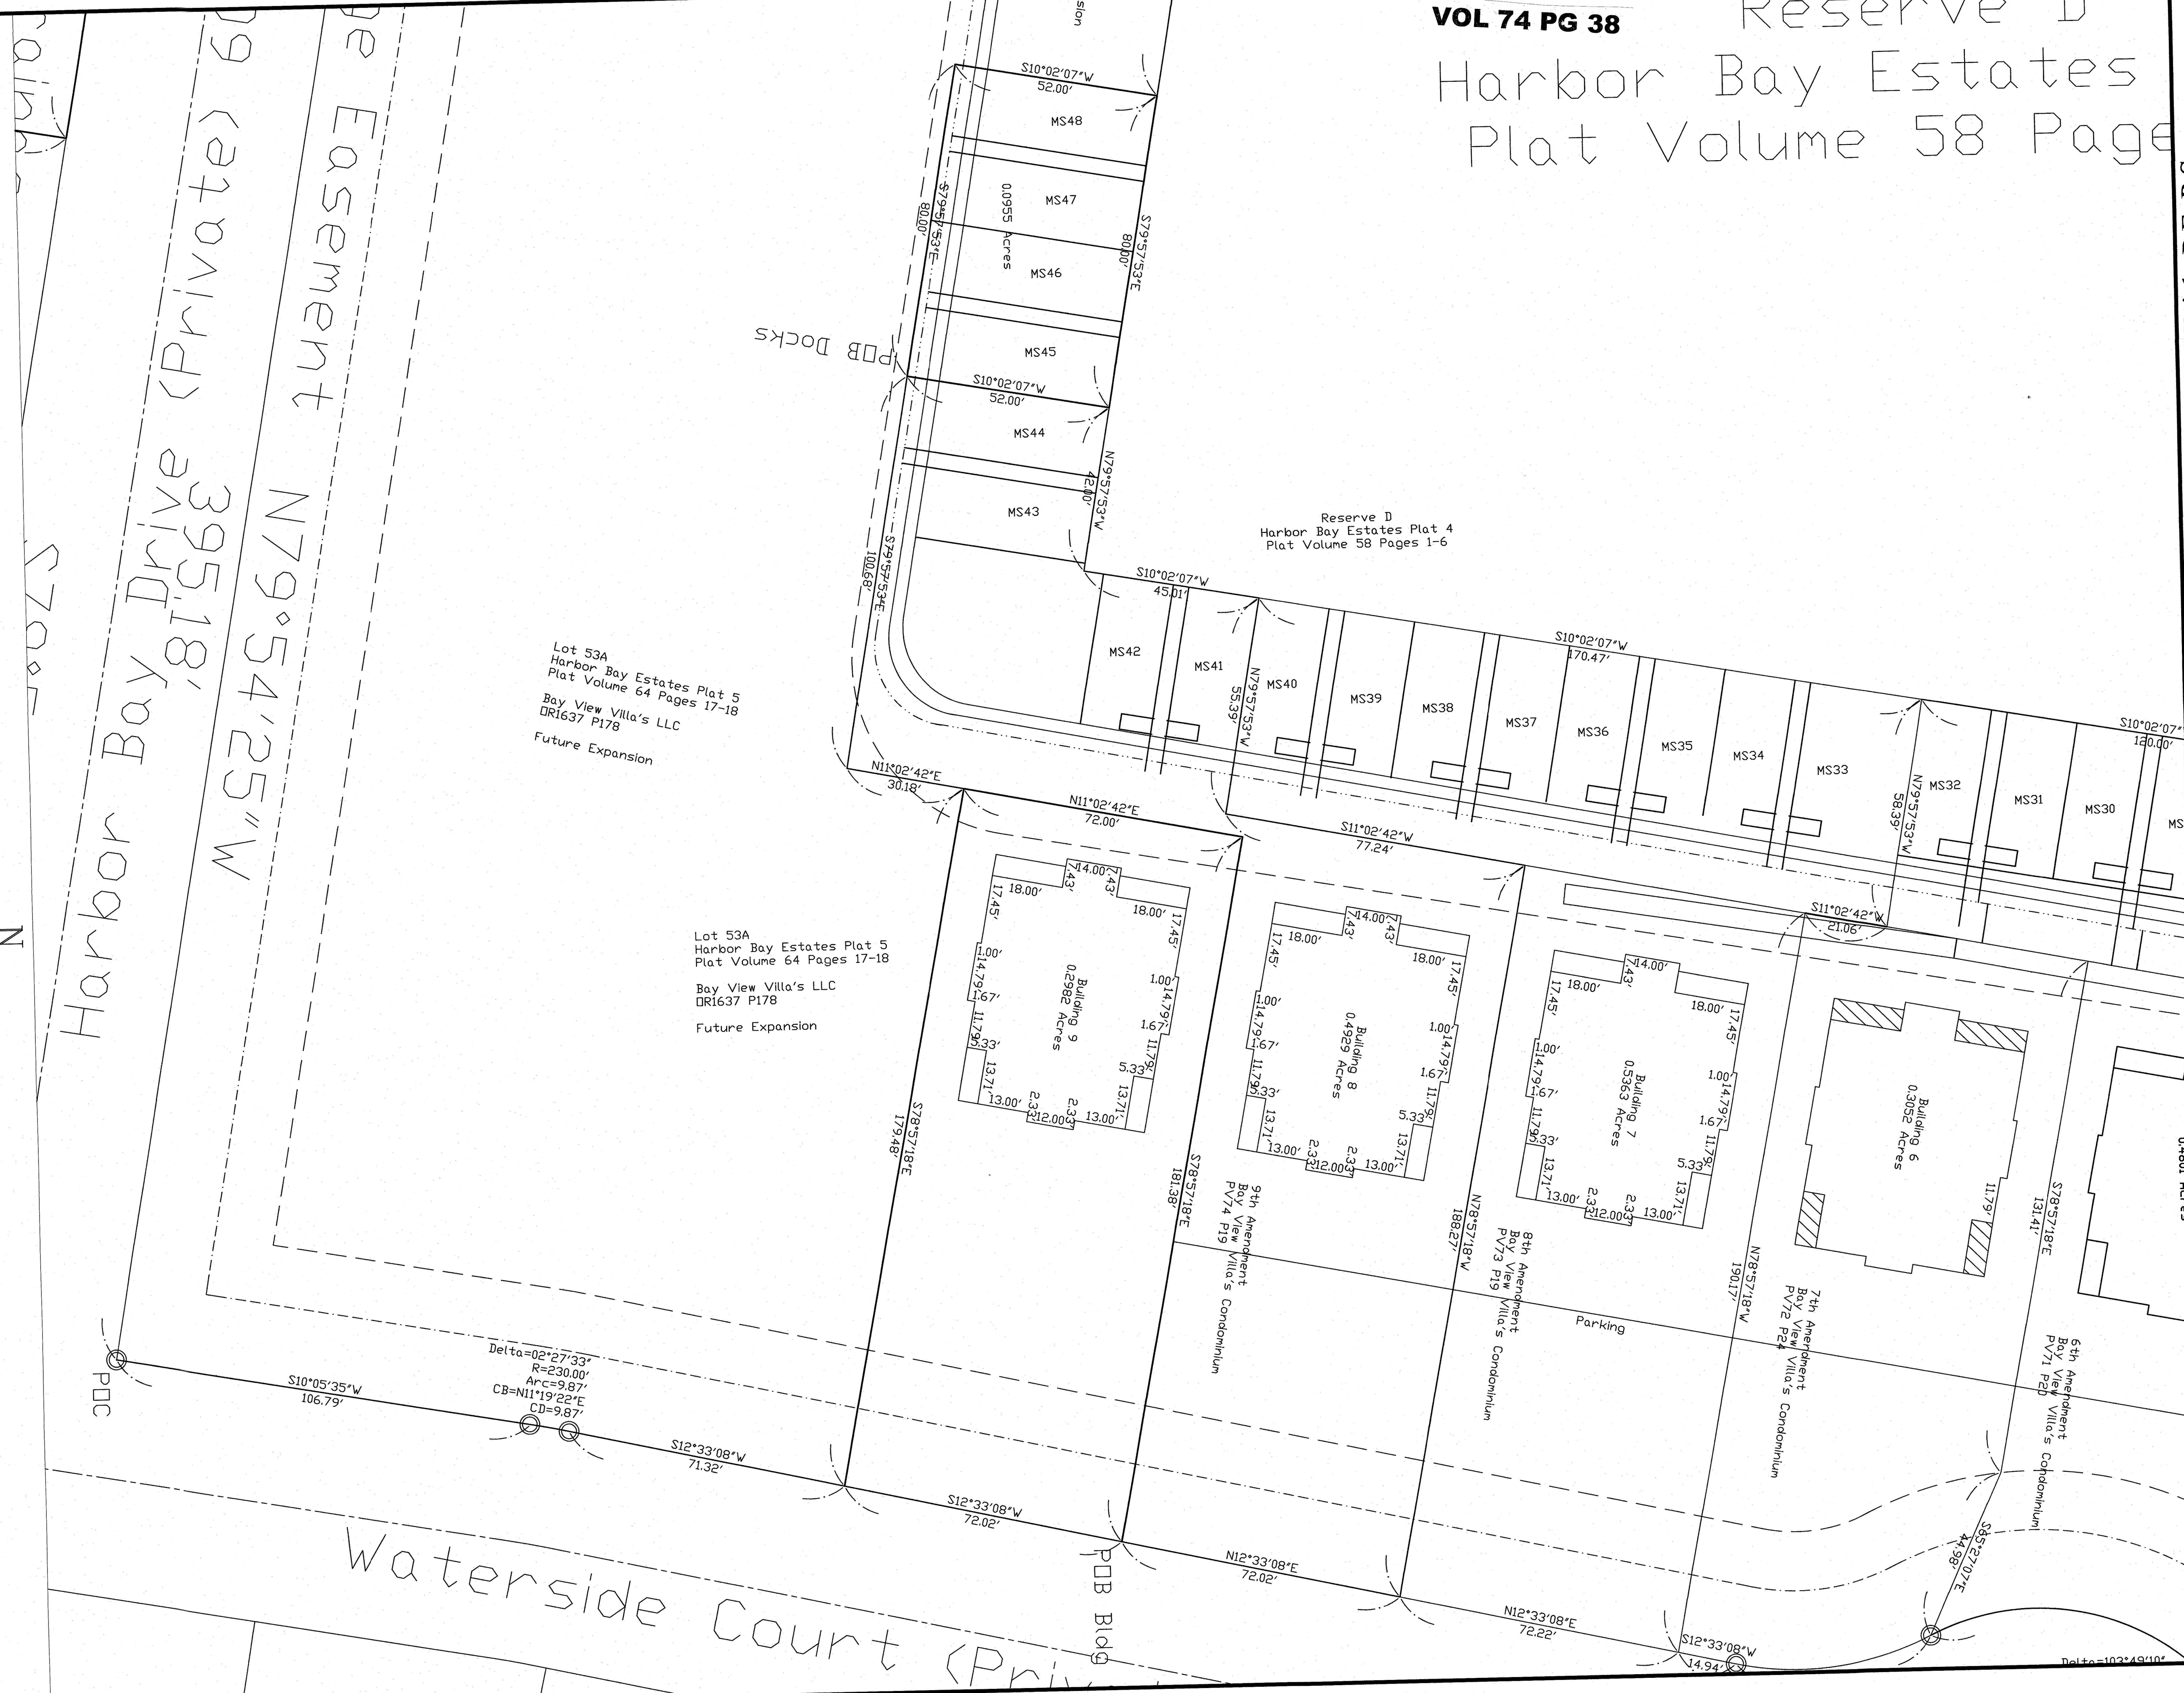

Lot 53A
 Harbor Bay Estates Plat 5
 Plat Volume 64 Pages 17-18
 Bay View Villa's LLC
 DR1637 P178
 Future Expansion


Lot 53A
 Harbor Bay Estates Plat 5
 Plat Volume 64 Pages 17-18
 Bay View Villa's LLC
 DR1637 P178
 Future Expansion

Reserve D
 Harbor Bay Estates Plat 4
 Plat Volume 58 Pages 1-6

Carl M Feick P.E. P.S.
 712 Bardwell Road
 Castalia, Ohio 44824
 419-656-3016 CFeick@compuserve.com

Created 07/06/2022

Bay View Villas Condominium,
 Tenth Amendment
 0.4603 Acres
 Being part of lot 53A of Harbor Bay Estates Plat 5, PV 64 P 17 & 18
 Section 4 lot 21, Danbury Township, Ottawa County, Ohio
 Owner: Marblehead Estates & Yacht Club, Ltd, 118 W South Boundary, Perrysburg, Ohio 43051
 419-873-8032

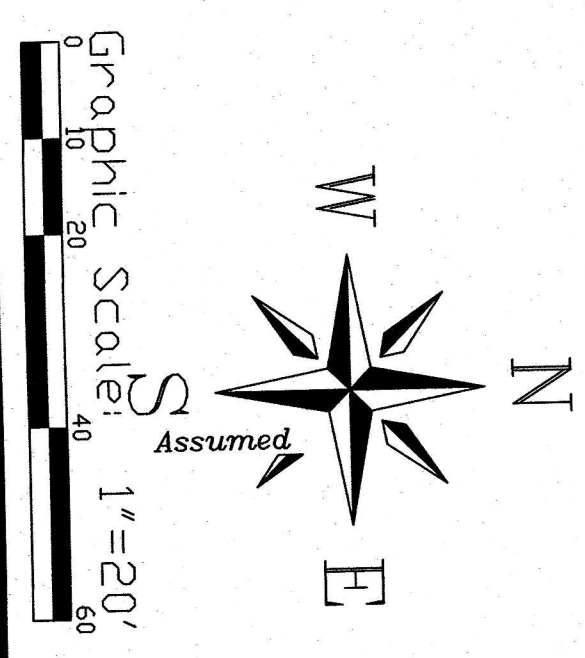

Certification
 I hereby certify that this drawing reflects the
 location of improvements and recorded easement
 to the best of my knowledge and belief.

