


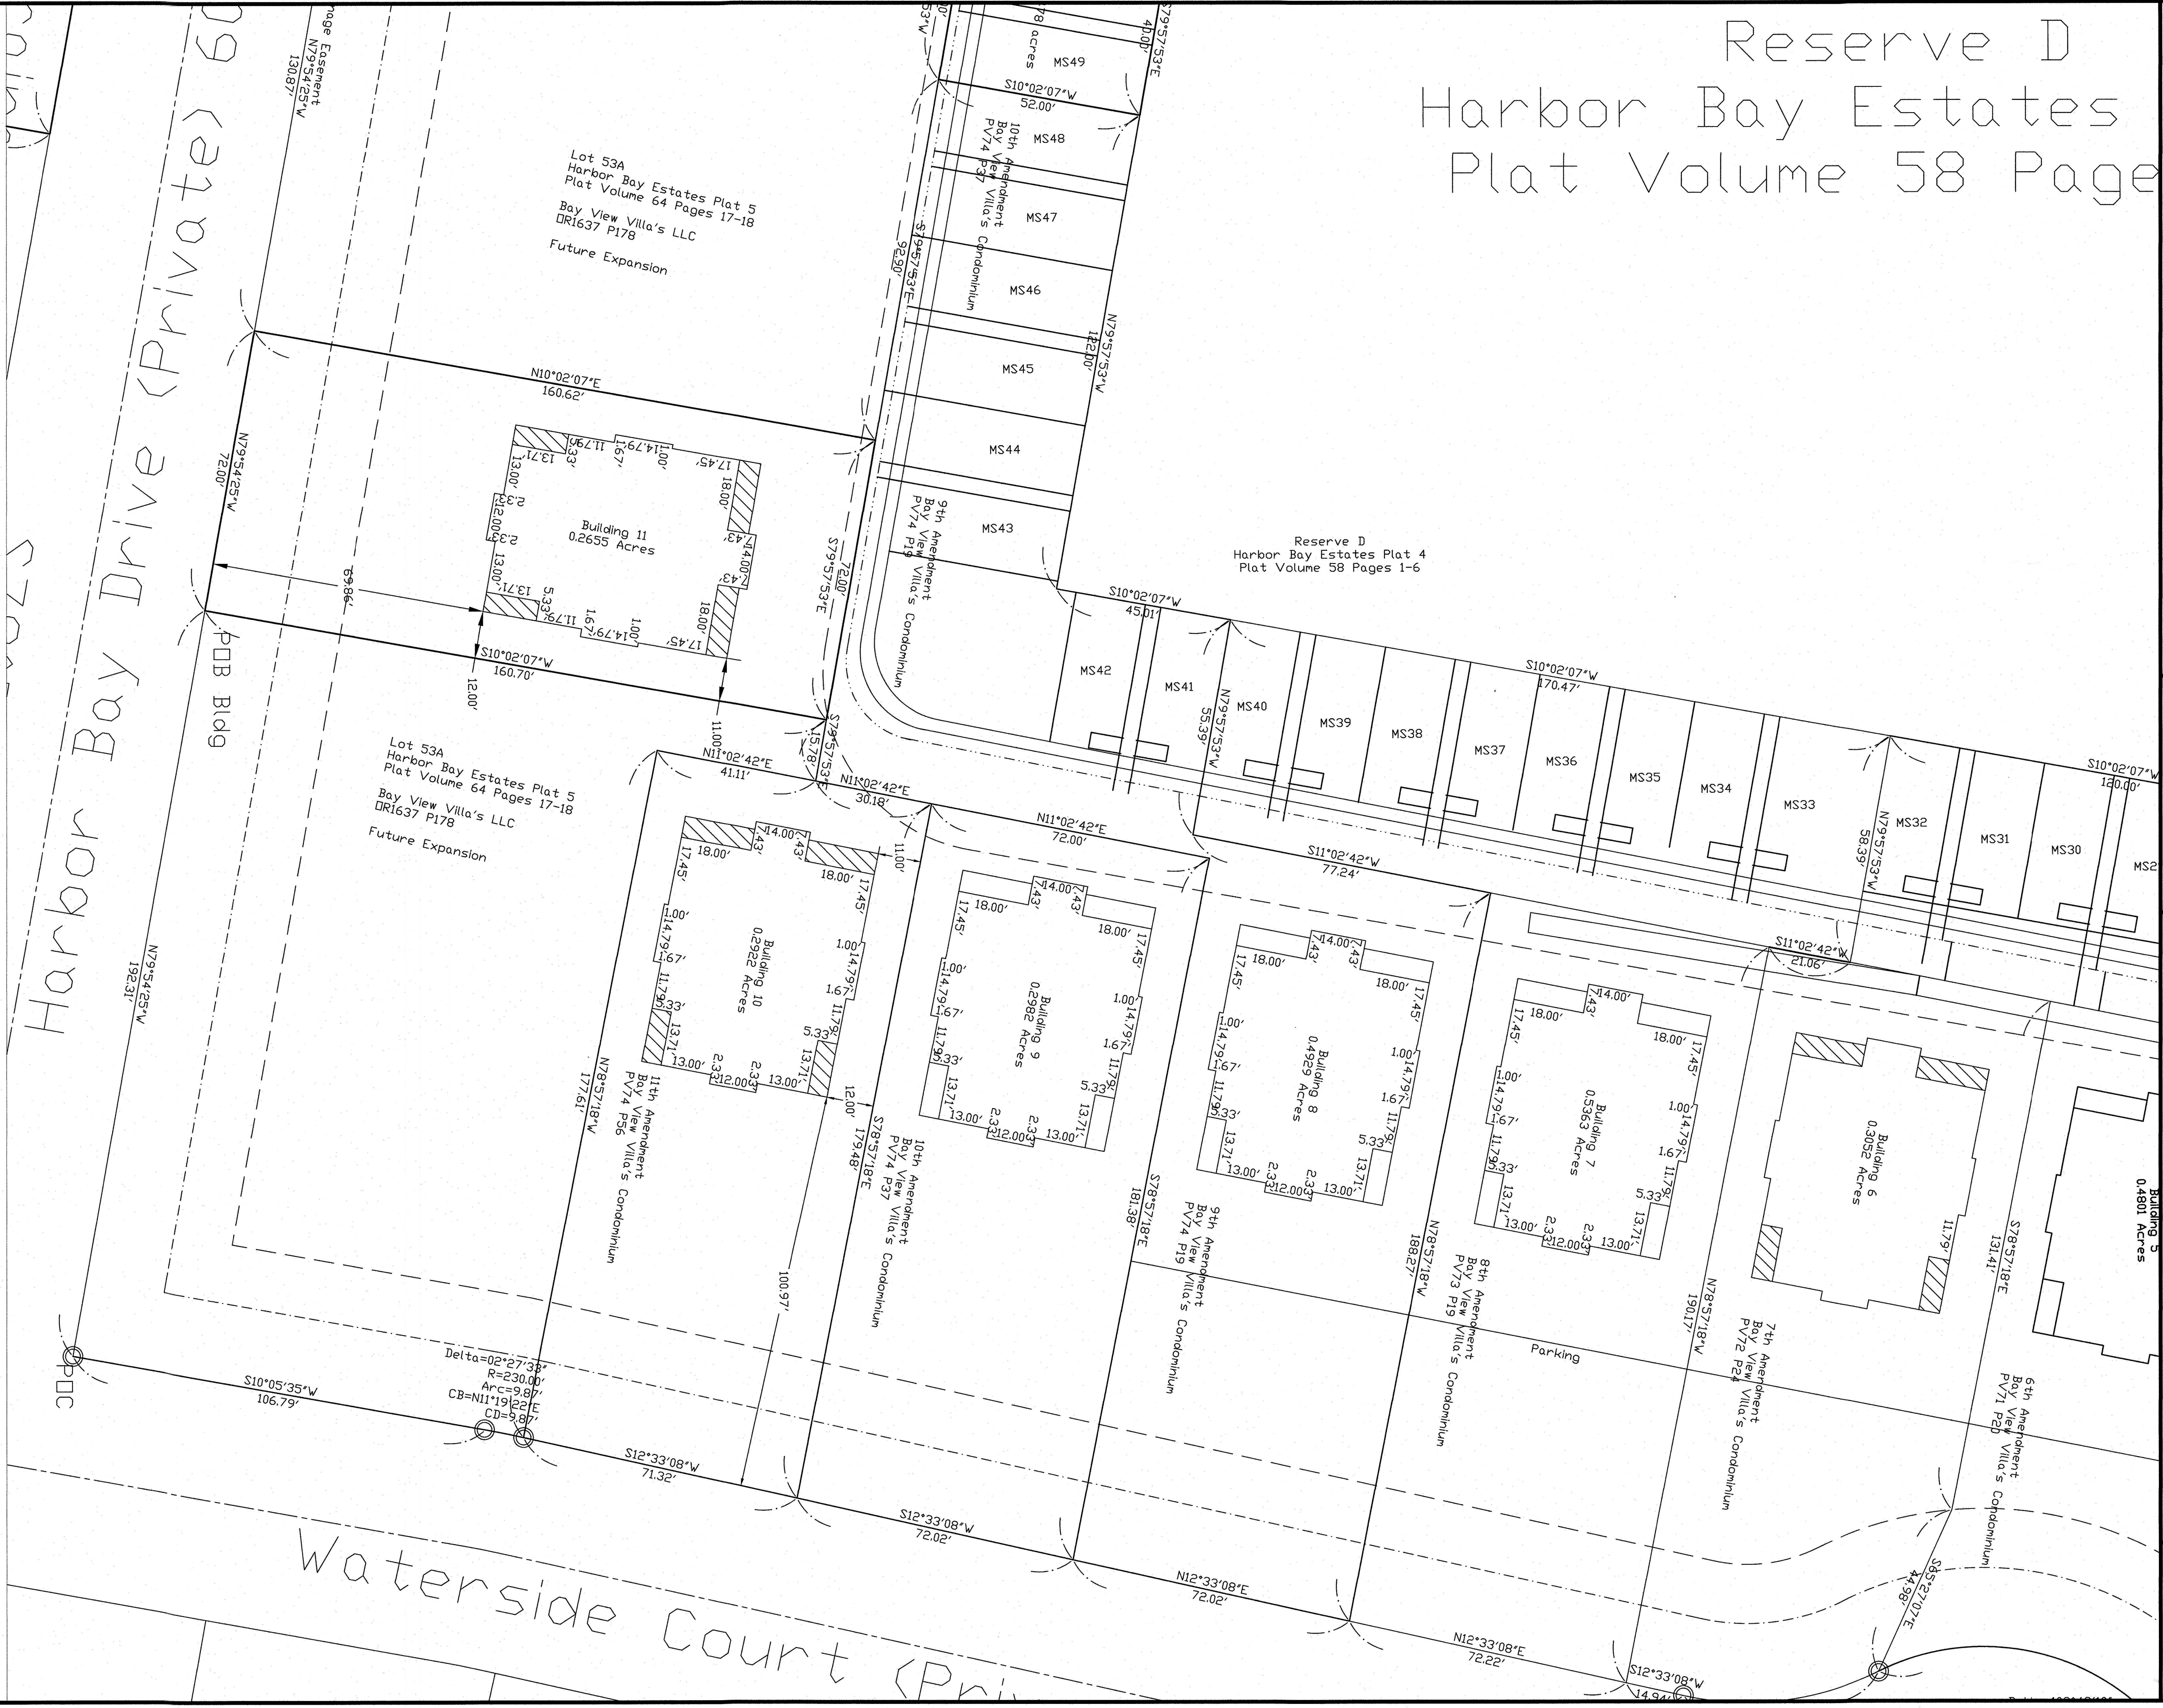

Reserve D  
Harbor Bay Estates  
Plat Volume 58 Page




Carl M Feick P.E. P.S.  
712 Bardwell Road  
Castalia, Ohio 44824  
419-656-3016 CFeick@compuserve.com

Created 09/18/2023

**Bay View Villas Condominium,**  
Twelfth Amendment  
Building 5  
0.4801 Acres

Being part of lot 53A of Harbor Bay Estates Plat 5, PV 64 P 17 & 18  
Section 4 lot 21, Danbury Township, Ottawa County, Ohio  
Owner: Marblehead Estates & Yacht Club, Ltd, 118 W South Boundary, Perrysburg, Ohio 43351  
419-873-8052

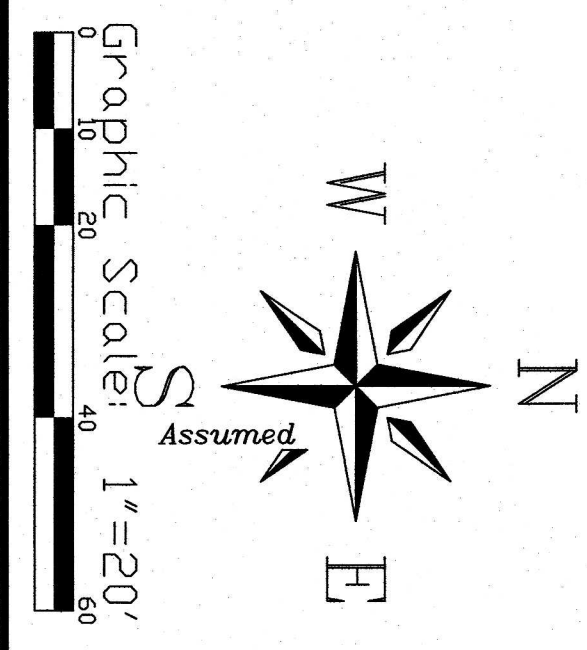

Certification  
I hereby certify that this drawing reflects the location of improvements and recorded easement to the best of my knowledge and opinion.

Carl M. Feick  
Professional Surveyor  
STATE OF OHIO  
S 70035

Delta=02°27'38"  
R=230.00'  
Arc=9.87'  
CB=N11°11'19"22"E  
CD=5.88'

9/28/2023  
Carl M. Feick P.S. 7035