

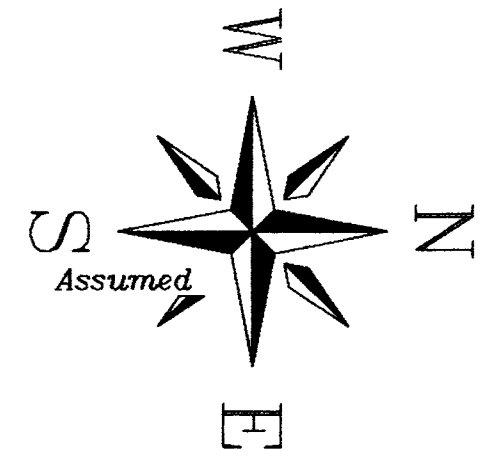
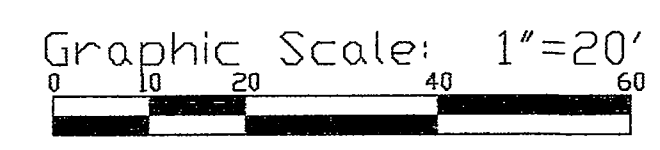


- Legend**
- Centerline
  - Setback line
  - Edge of water top of bank 577.00
  - easement line
  - Limited Common Area
  - 1/2" Iron pin in concrete
  - 5/8" Iron pin set

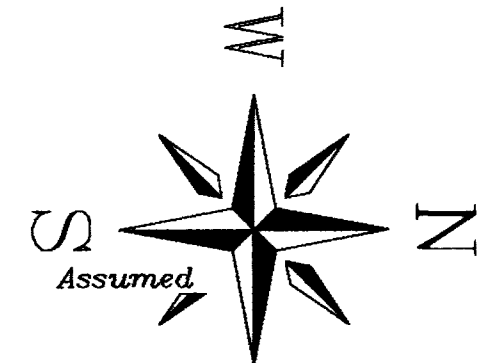

Carl M Feick P.E. P.S.  
 712 Bardwell Road  
 Castalia, Ohio 44824  
 419-656-3016 CFeick@compuserve.com

Created 08/17/2021  
 09/7/2021 added  
 labels, Lot areas

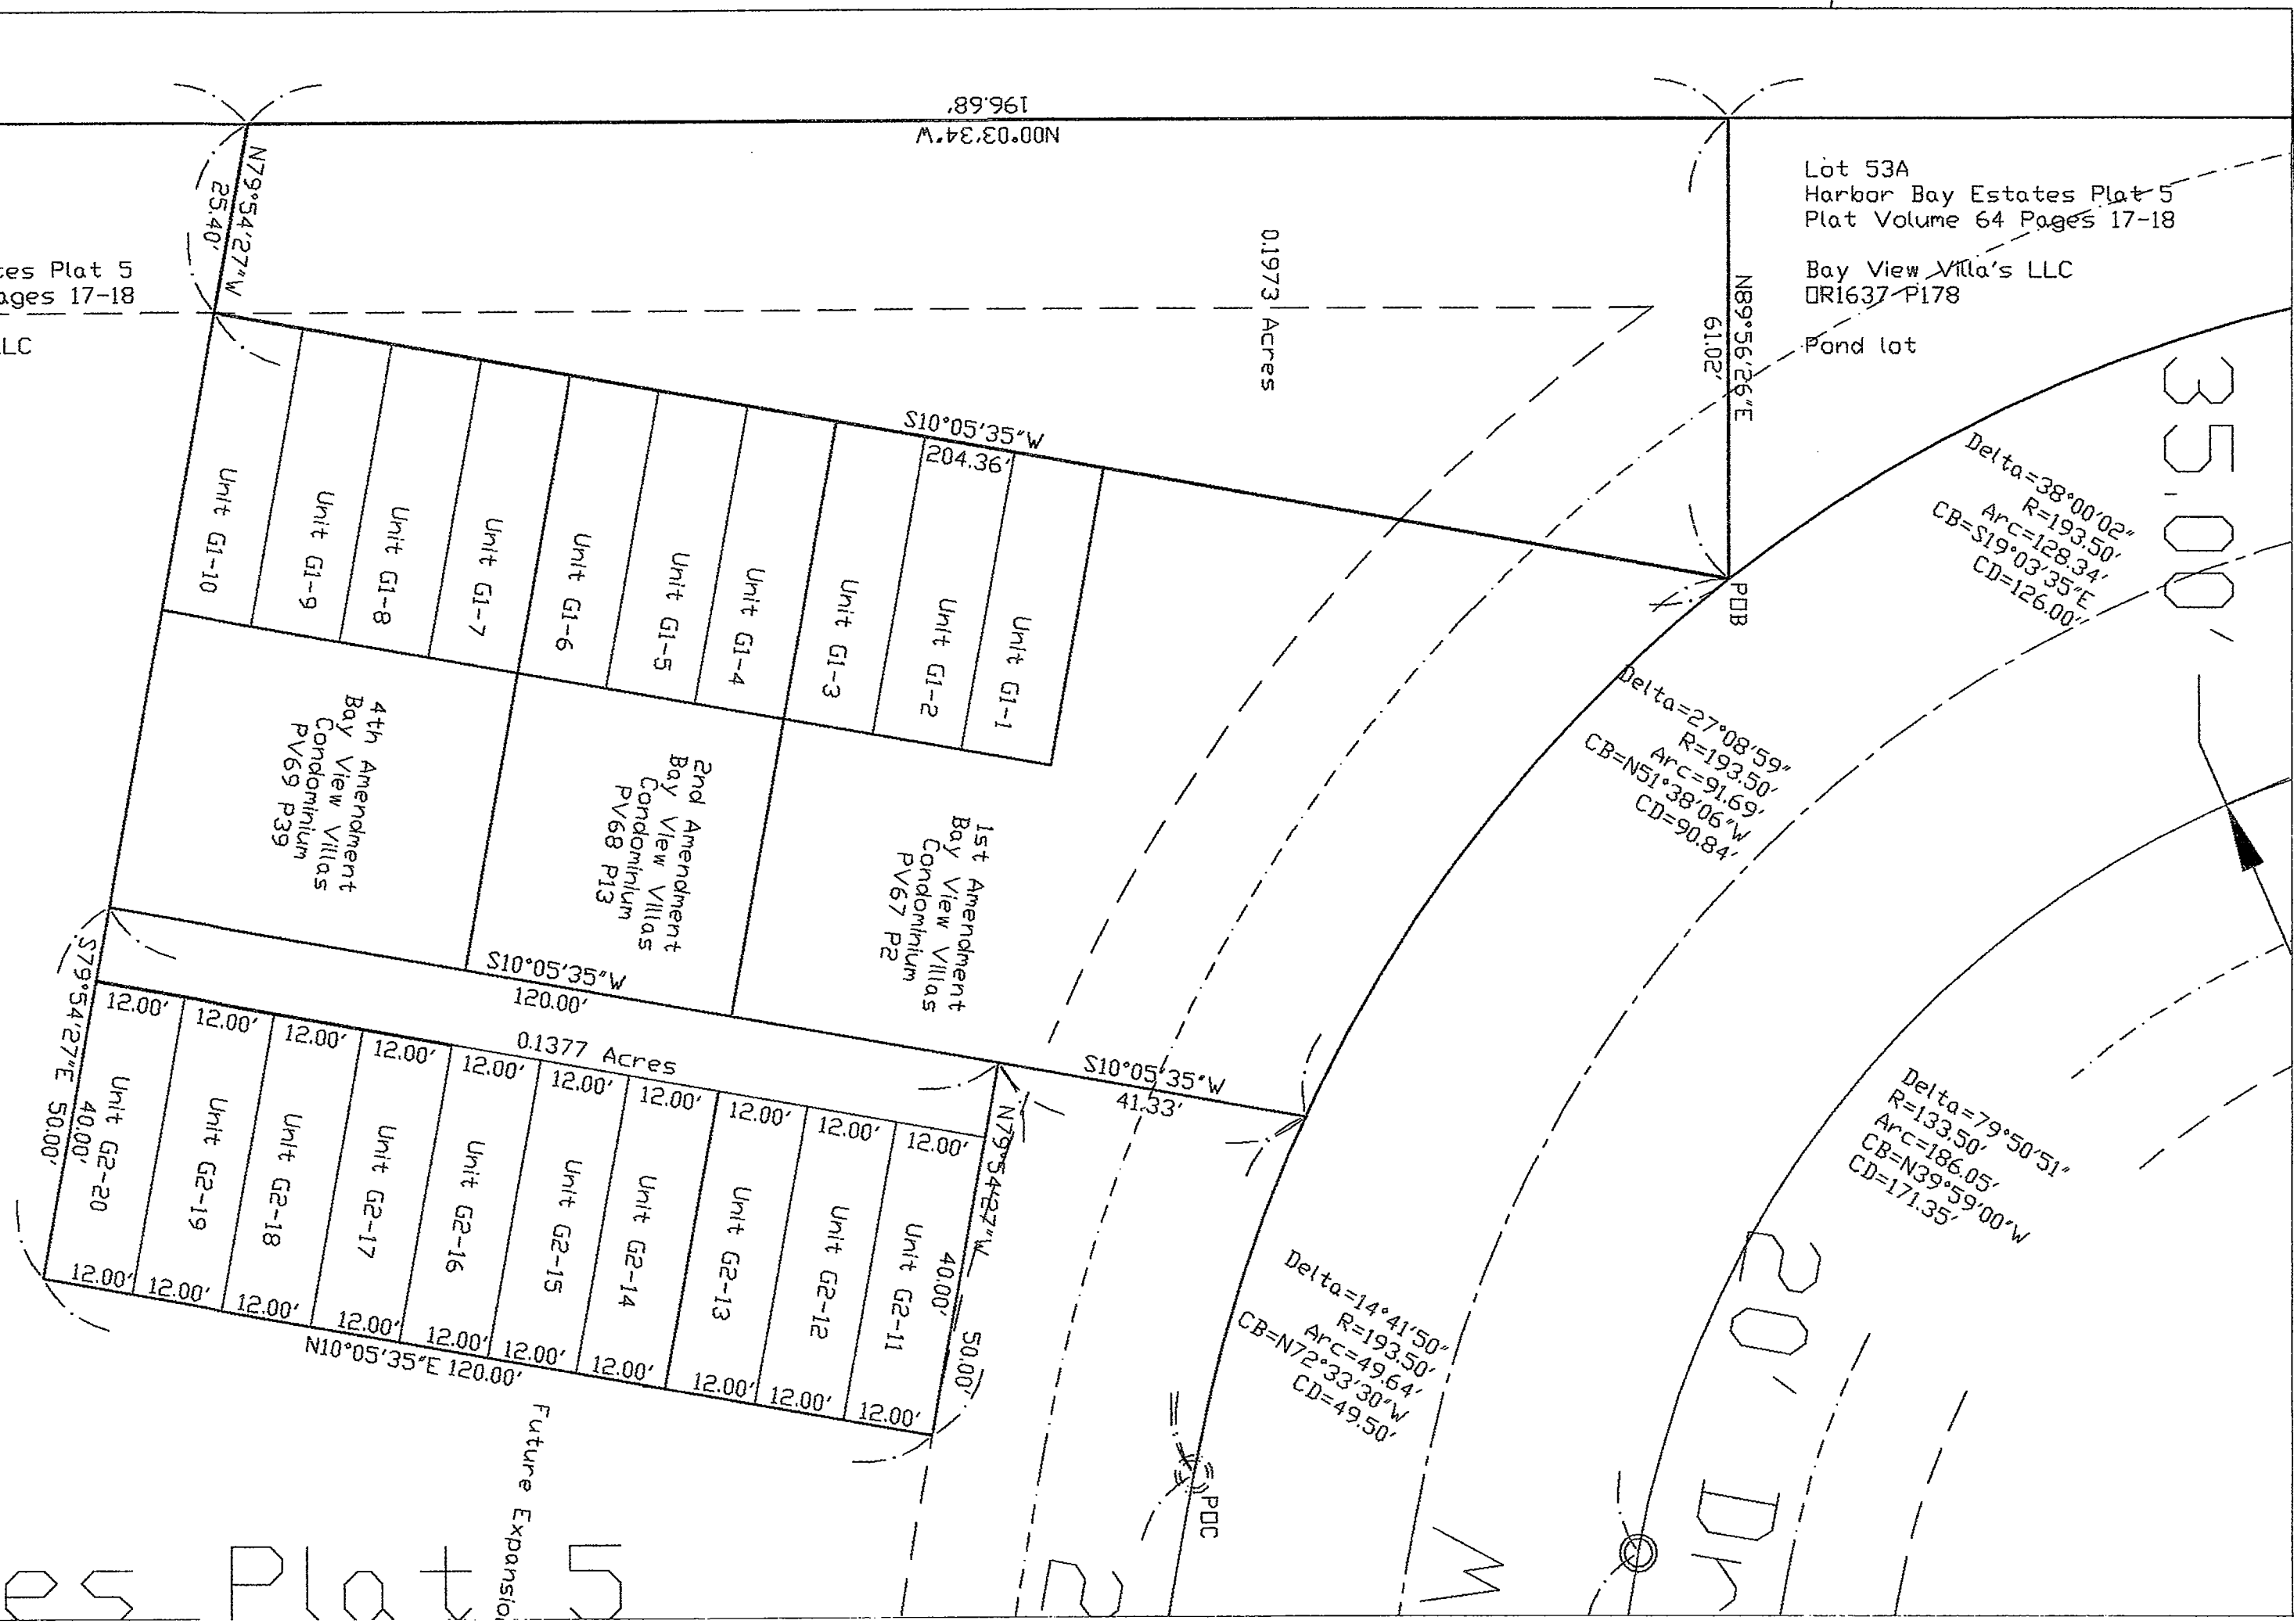

Certification  
 I hereby certify that this drawing reflects the location of improvements and recorded easement to the best of my knowledge and belief.

*Carl M. Feick*  
 Carl M. Feick P.S. 7035  
 Dated 8/17/2021

Ottawa County Recorder  
 #  
 Filed for Record this \_\_\_ Day of \_\_\_\_\_ 2021  
 at \_\_\_\_\_  
 Recorded this \_\_\_ Day of \_\_\_\_\_  
 in Plat Book \_\_\_ pages \_\_\_\_\_

Document # 311304 Vol. 73 PG 19-20  
 Date 10-04-2021 Time 2:36 pm  
 Fee \$146.20  
*Nathan Daniels*  
 Nathan Daniels  
 Recorder, Ottawa County Ohio

Being part of lot 53A of Harbor Bay Estates Plat 5, PV 64 P 17 & 18  
 Section 4 lot 21, Dambury Township, Ottawa County, Ohio  
 Owner: Marblehead Estates & Yacht Club, Ltd, 118 W South Boundary, Perrysburg, Ohio 43551  
 419-873-8052

**Bay View Villas Condominium,**  
 Eighth Amendment

v Fstates Plat 5