



Certification
 I hereby certify that this drawing reflects the location of improvements and recorded easement to the best of my knowledge and belief.

Carl M. Feick 3/30/2022

Carl M. Feick P.S. 7035
 Dated 8/17/2021

Ottawa County Recorder
 # 2022-316530
 Filed for Record this 4 Day of April 2022
 at 2:56 pm
 Recorded this 4 Day of April 2022
 in Plat Book 74 pages 19-20

Nathan Daniels by a.k.t

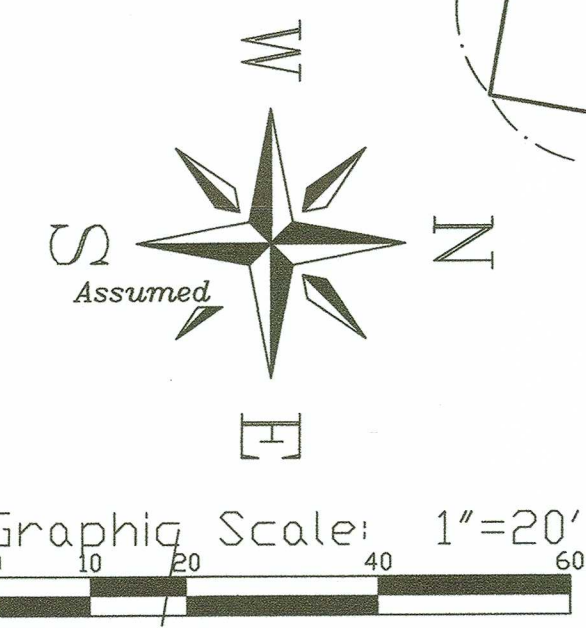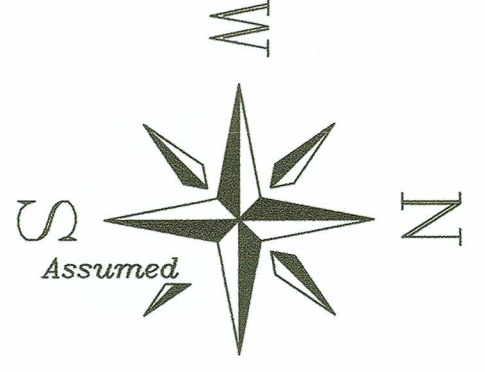

Carl M Feick P.E. P.S.
 712 Bardwell Road
 Castalia, Ohio 44824
 419-656-3016 CFeick@compuserve.com

Created 02/22/2022
 rev 3/23/2022 CMF


Ninth Amendment
Bay View Villas Condominium,
 Being part of lot 53A of Harbor Bay Estates Plat 5, PV 64 P 17 & 18
 Section 4 lot 21, Danbury Township, Ottawa County, Ohio
 Owner: Marblehead Estates & Yacht Club, Ltd, 118 W South Boundary, Perrysburg, Ohio 43551
 419-873-8052

Carl M Feick P.E. P.S.
712 Bardwell Road
Castalia, Ohio 44824

419-656-3016 CFeick@compuserve.com

Created 02/22/2022
rev 3/23/2022 CMF
rev 3/24/2022 CMF

Ninth Amendment
Bay View Villas Condominium,
Being part of lot 53A of Harbor Bay Estates Plat 5, PV 64 P 17 & 18
Section 4 lot 21, Danbury Township, Ottawa County, Ohio
Owner: Marblehead Estates & Yacht Club, Ltd, 118 W South Boundary, Perrysburg, Ohio 43551
419-873-8052

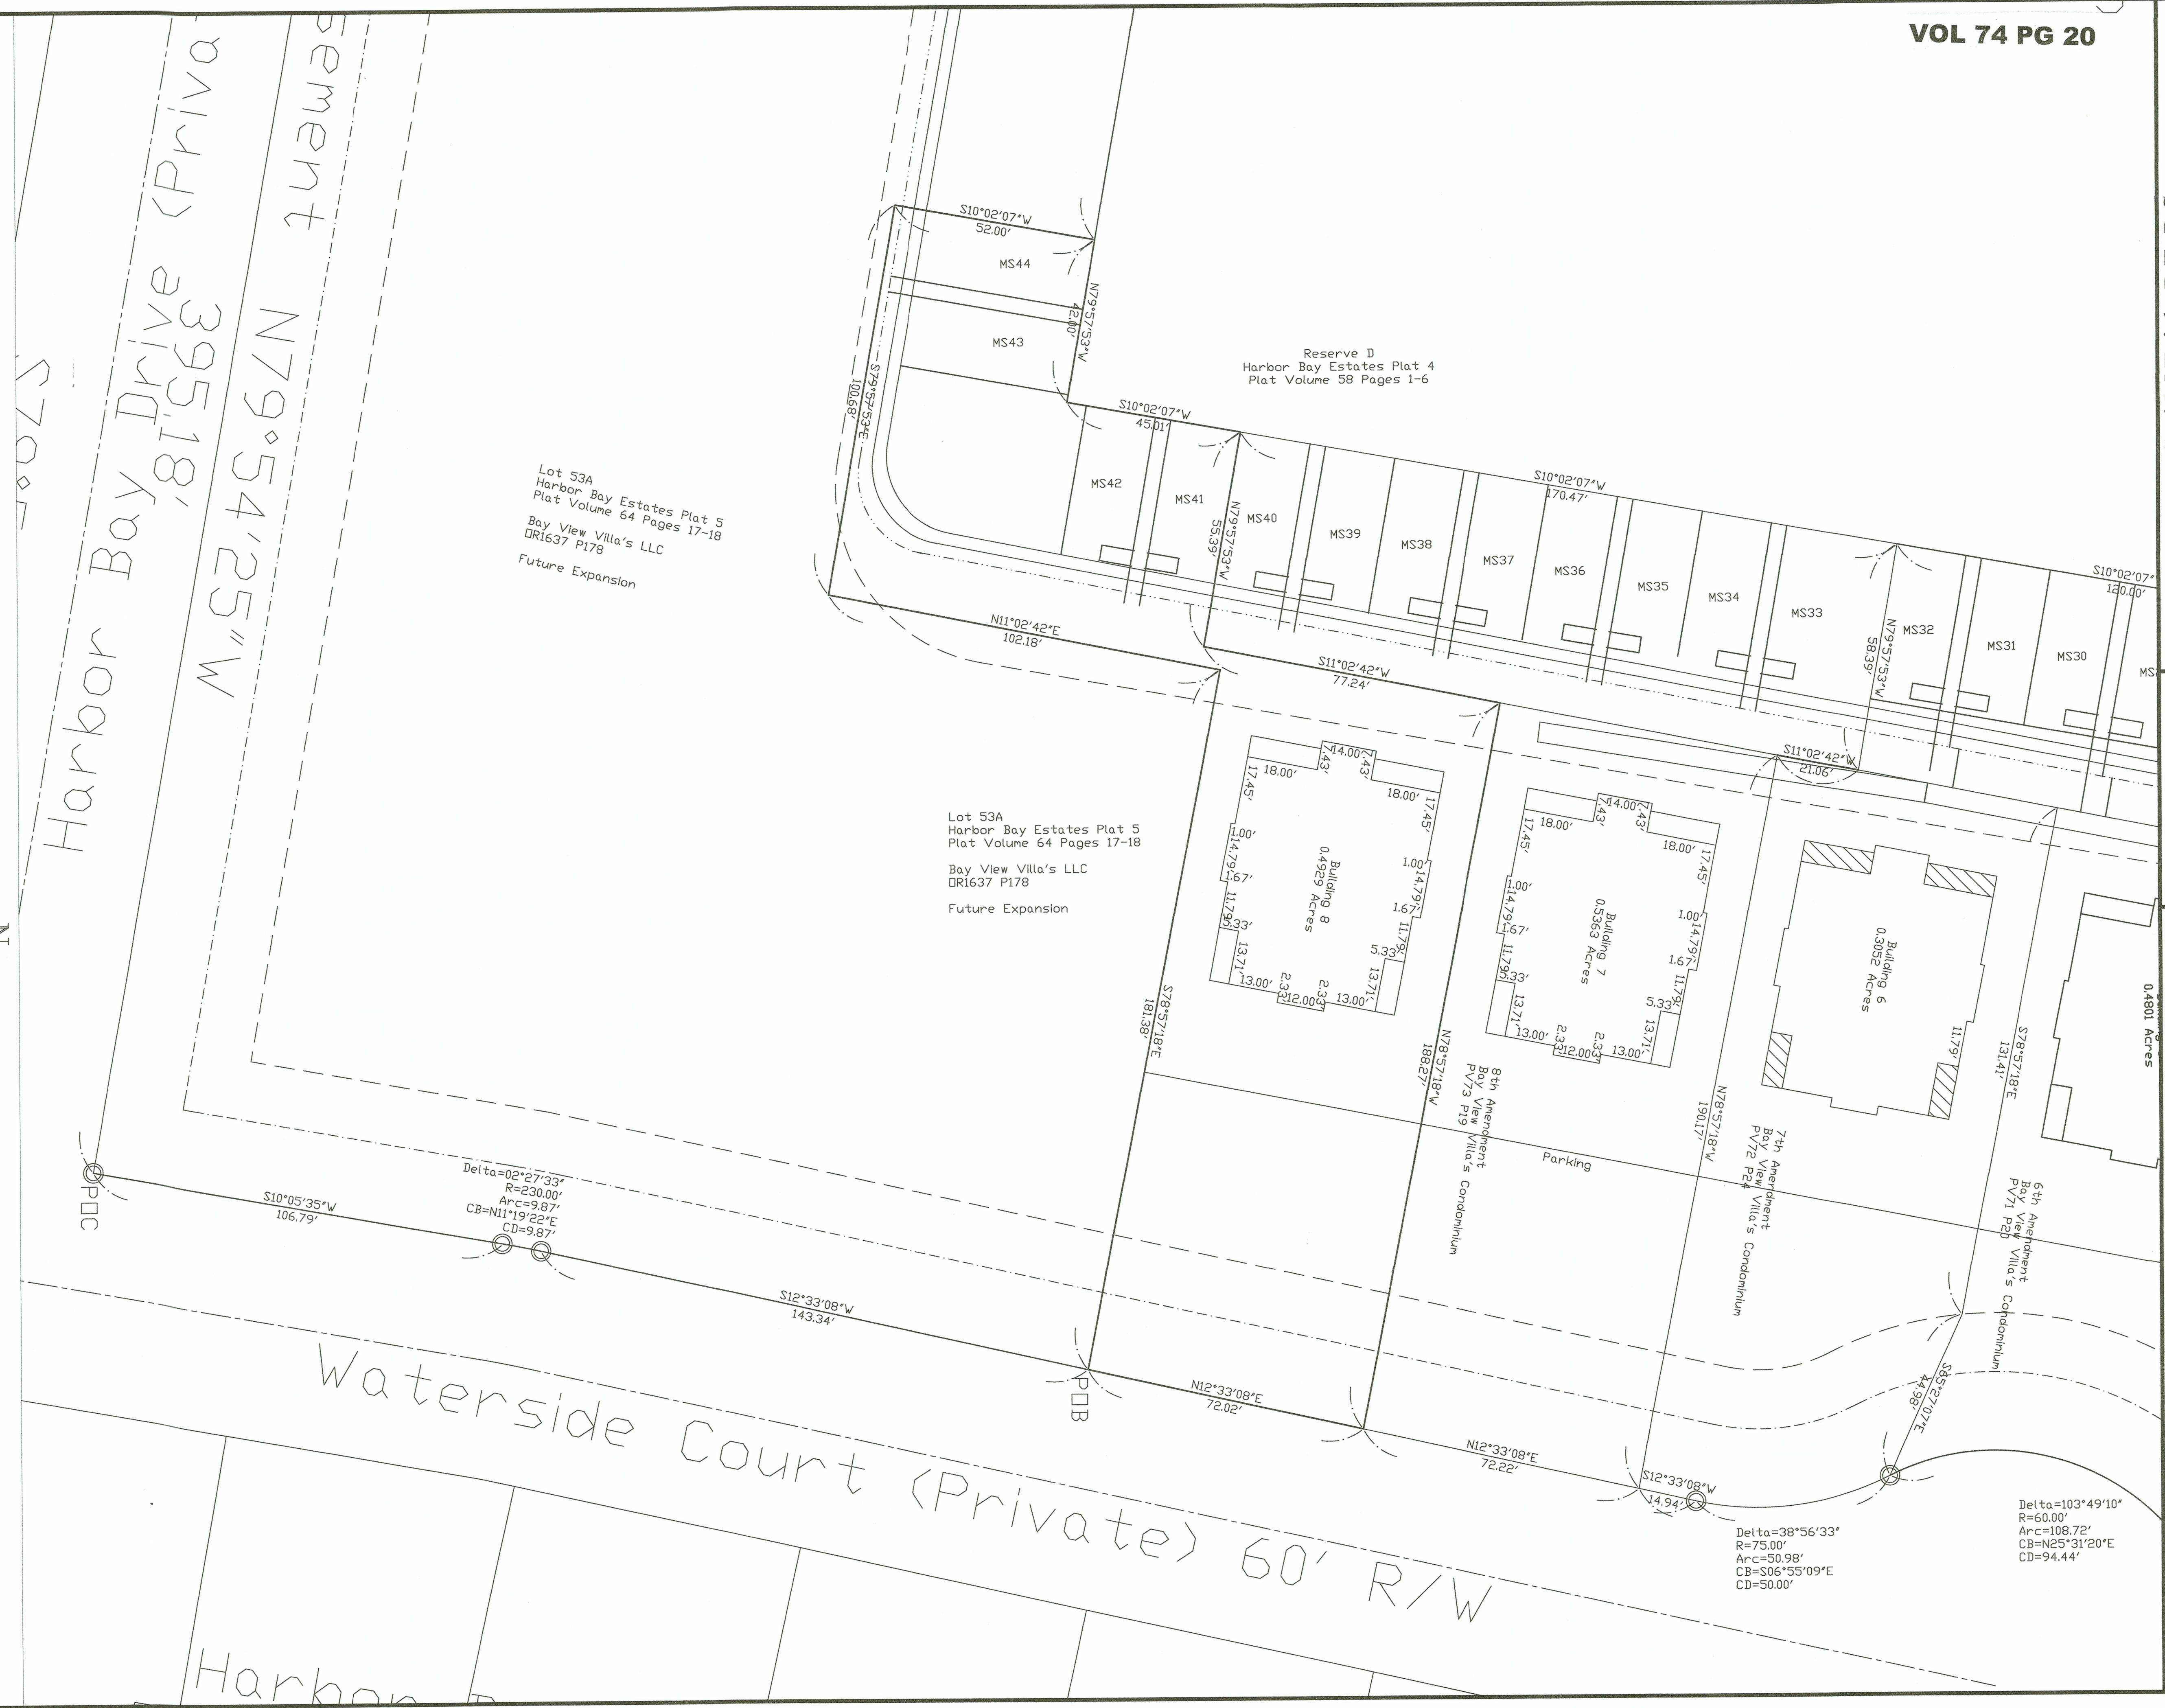

Harbor Bay Drive (Private)
395.18'
81.563'
W 79°54'25"W
179.56'


Waterside Court (Private) 60' R/W

Lot 53A
Harbor Bay Estates Plat 5
Plat Volume 64 Pages 17-18
Bay View Villa's LLC
DR1637 P178
Future Expansion

Lot 53A
Harbor Bay Estates Plat 5
Plat Volume 64 Pages 17-18
Bay View Villa's LLC
DR1637 P178
Future Expansion



Certification
I hereby certify that this drawing reflects the
location of improvements and recorded easement
to the best of my knowledge and belief.

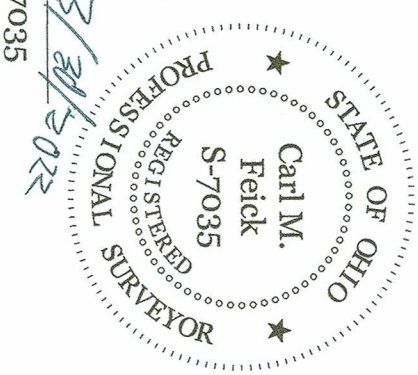

Carl M. Feick P.S. 7035