Vol. 22 | 3

SITE PLAN
for
BLUE WATER CONDOMINIUM
PART OF LOT 13, SEC. 2, FIRELANDS SURVEY
DANBURY TOWNSHIP, OTTAWA COUNTY, OHIO
1985

#23355
Received: August 19, 1986 Time: 1:50 P.M.
Recorded: August 18, 1986
Vol. 22 Pg. 3 Fee: $35.35
William R. Kasser, Recorder

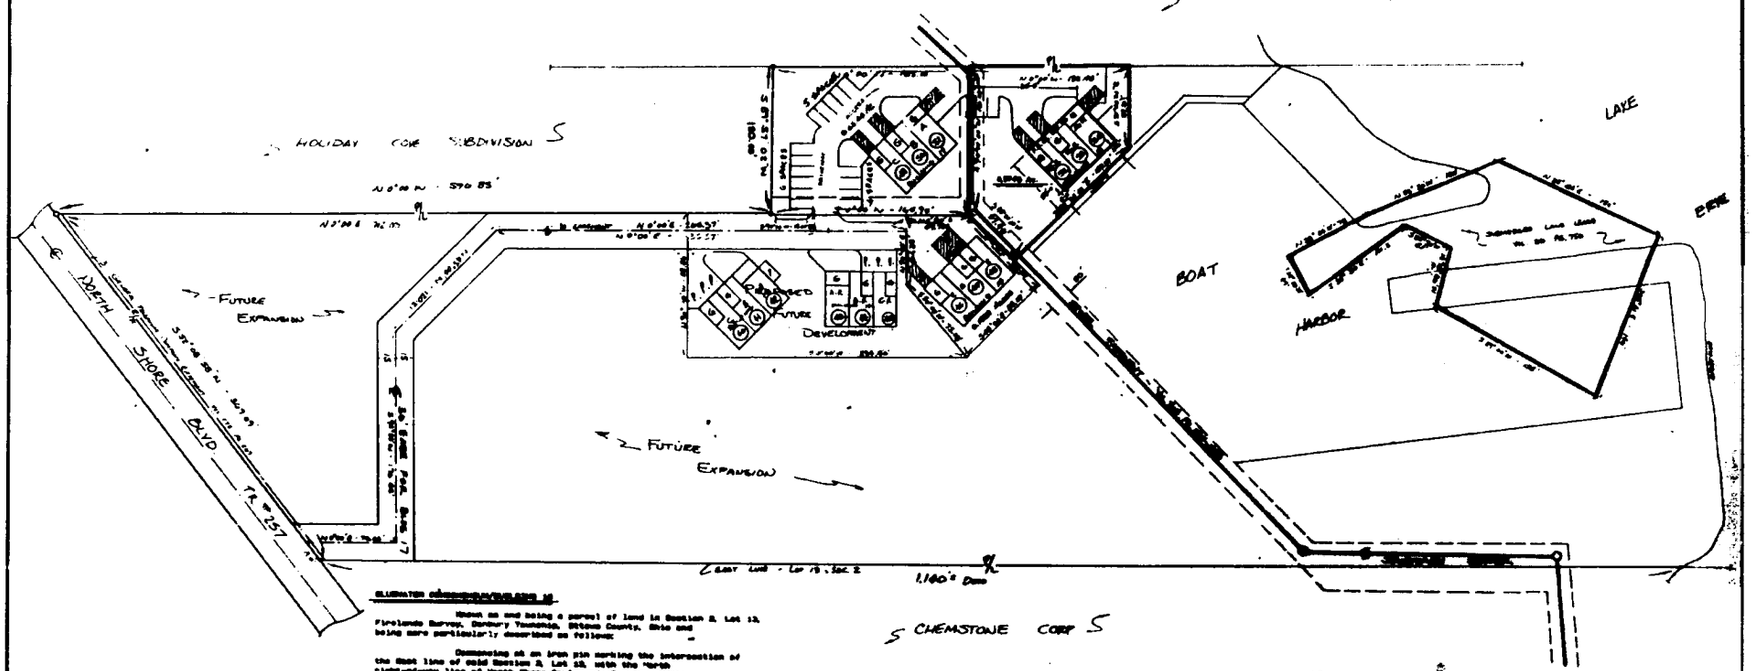

Building 18
Unit Floor Areas

Unit 32 = 1709 ft²
Unit 33 = 1640 ft²
Unit 34 = 1712 ft²

Building 18
First Floor Elevation = [illegible] Datum

Limited Common Area
Front Entrance Office
Front Wood Deck

NORTH
Scale 1"=50'

The within drawings accurately show the building or buildings as constructed.

Dave A. Brandebury, P.E., P.S.
705 West Lake Street Road
Oak Harbor, Ohio 43449
Professional Engineer 39140
Registered Surveyor 6596

7/29/86
Date