


HEATING FLOOR PLAN
SCALE: 1/4"=1'-0"

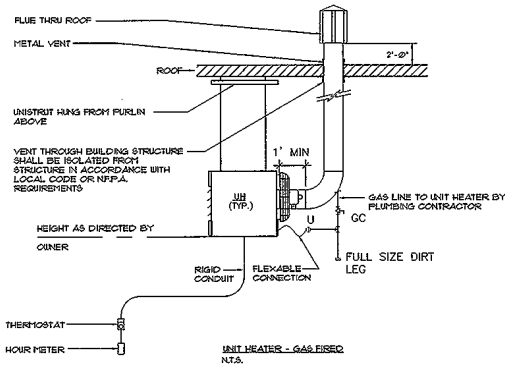

UNIT HEATER SCHEDULE											
MARK	SERVICE	MANFR	MODEL	INPUT MBH	OUTPUT MBH	FAN TYPE	FLUE CONN	ELECTRICAL			REMARKS
								HP	VOLTAGE	PHASE	
UH-1	STORAGE	REZNOR	UDAP60	60	49.80	PROP	6" x 4"	1/8	115	1	SEE NOTE

NOTE: FURNISH WITH SPACE THERMOSTAT SUITABLE FOR LOW RANGE POWER VENTED UNIT WITH 81% EFFICIENCY 66 LBS HORIZONTAL ADJUSTABLE LOUVERS


I HEREBY CERTIFY TO THE BEST OF MY KNOWLEDGE THIS DRAWING OF EAST HARBOR CONDOMINIUM STORAGE, BUILDING D, UNITS D1-D5 INCLUSIVE ACCURATELY REPRESENTS THE UNITS AS CONSTRUCTED.

Robert J. Aczlarri
ROBERT J. ACZLARRI REGISTERED ARCHITECT #28281

REVISIONS
DATE 07/15/07

JOB NO. Y2122

EX-B
SHEET NO. 3 OF 5

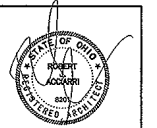

ADA ARCHITECTS, INC.
PROFESSIONAL ARCHITECTS AND INTERIORS INCORPORATED
UNIVERSITY PARK, OHIO 44122-1000
PHONE (216) 521-4824 FAX (216) 521-4824
WWW.ADAARCHITECTS.COM

PROPOSED - WAREHOUSE DEVELOPMENT BLDG. 'D'
5831 S.R. 163
DANBURY TWP., OHIO
17710 DETROIT AVENUE LAKEWOOD, OHIO 44107
ADA ARCHITECTS, INC. PHONE (216) 521-4824 FAX (216) 521-4824
WWW.ADAARCHITECTS.COM

