



DATE: 3/13/17
 REVIEW:
 REVISION: 1
 2

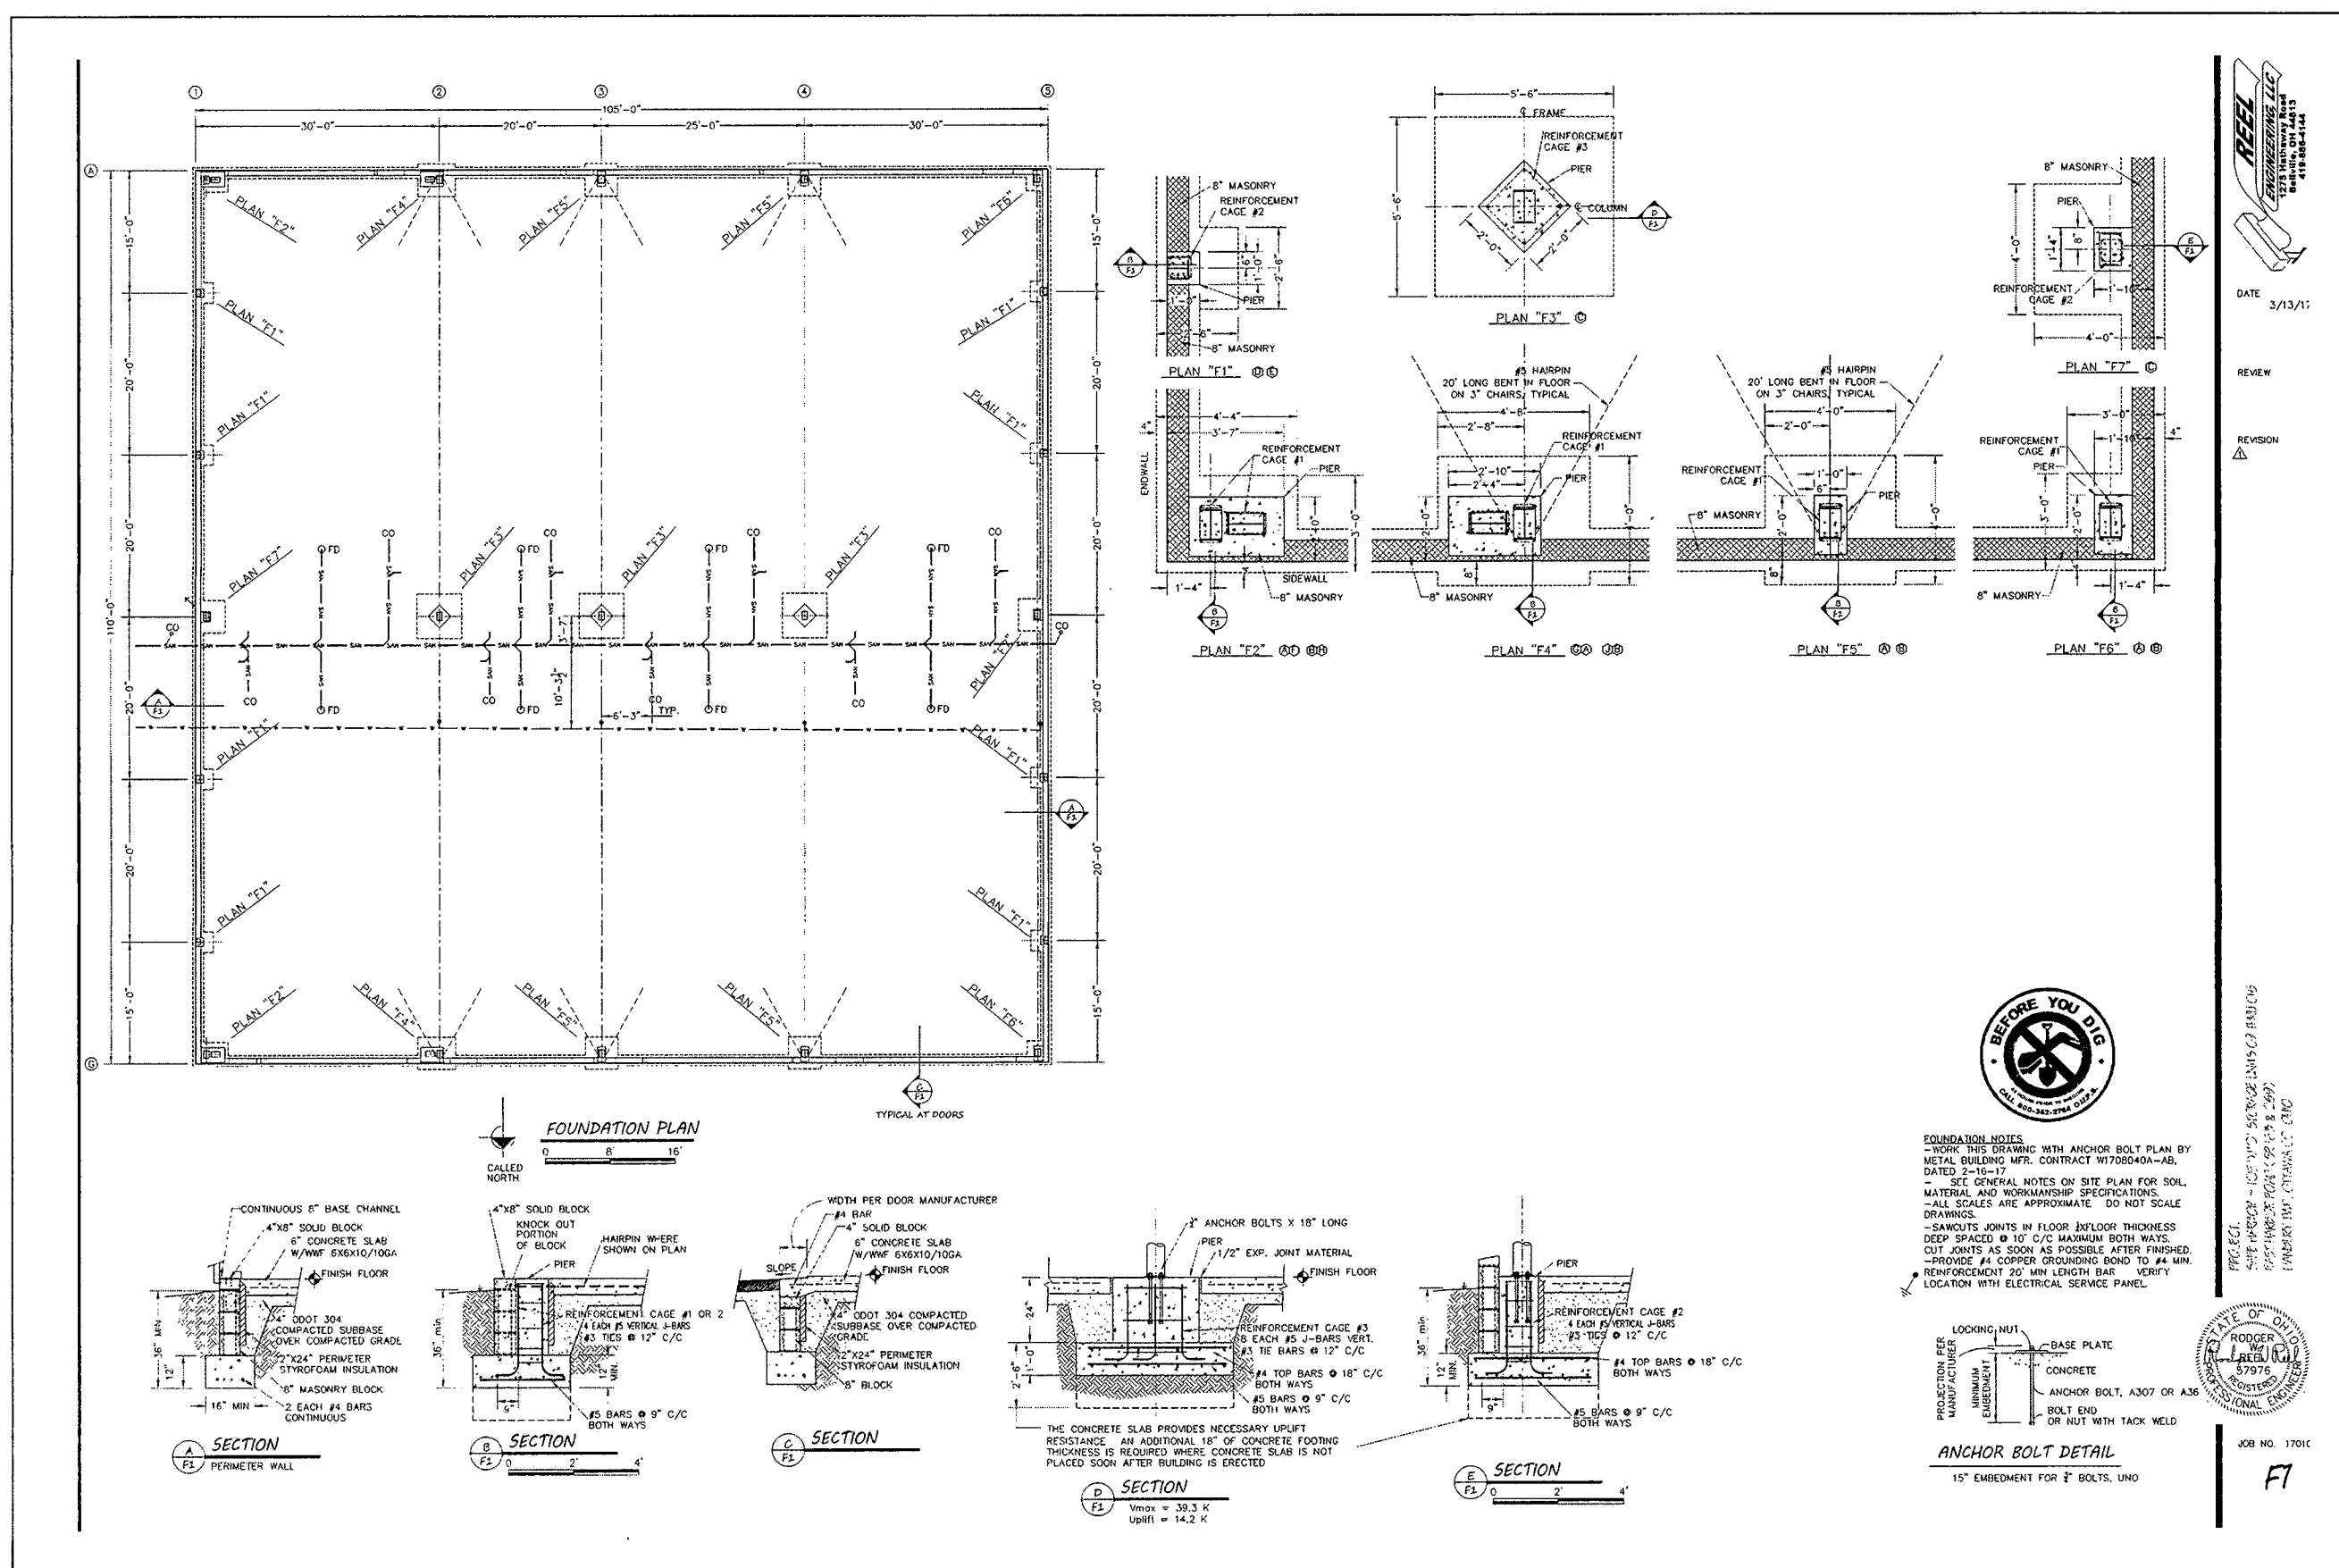


DATE: 3/13/17
 REVIEW:
 REVISION: 1
 F1

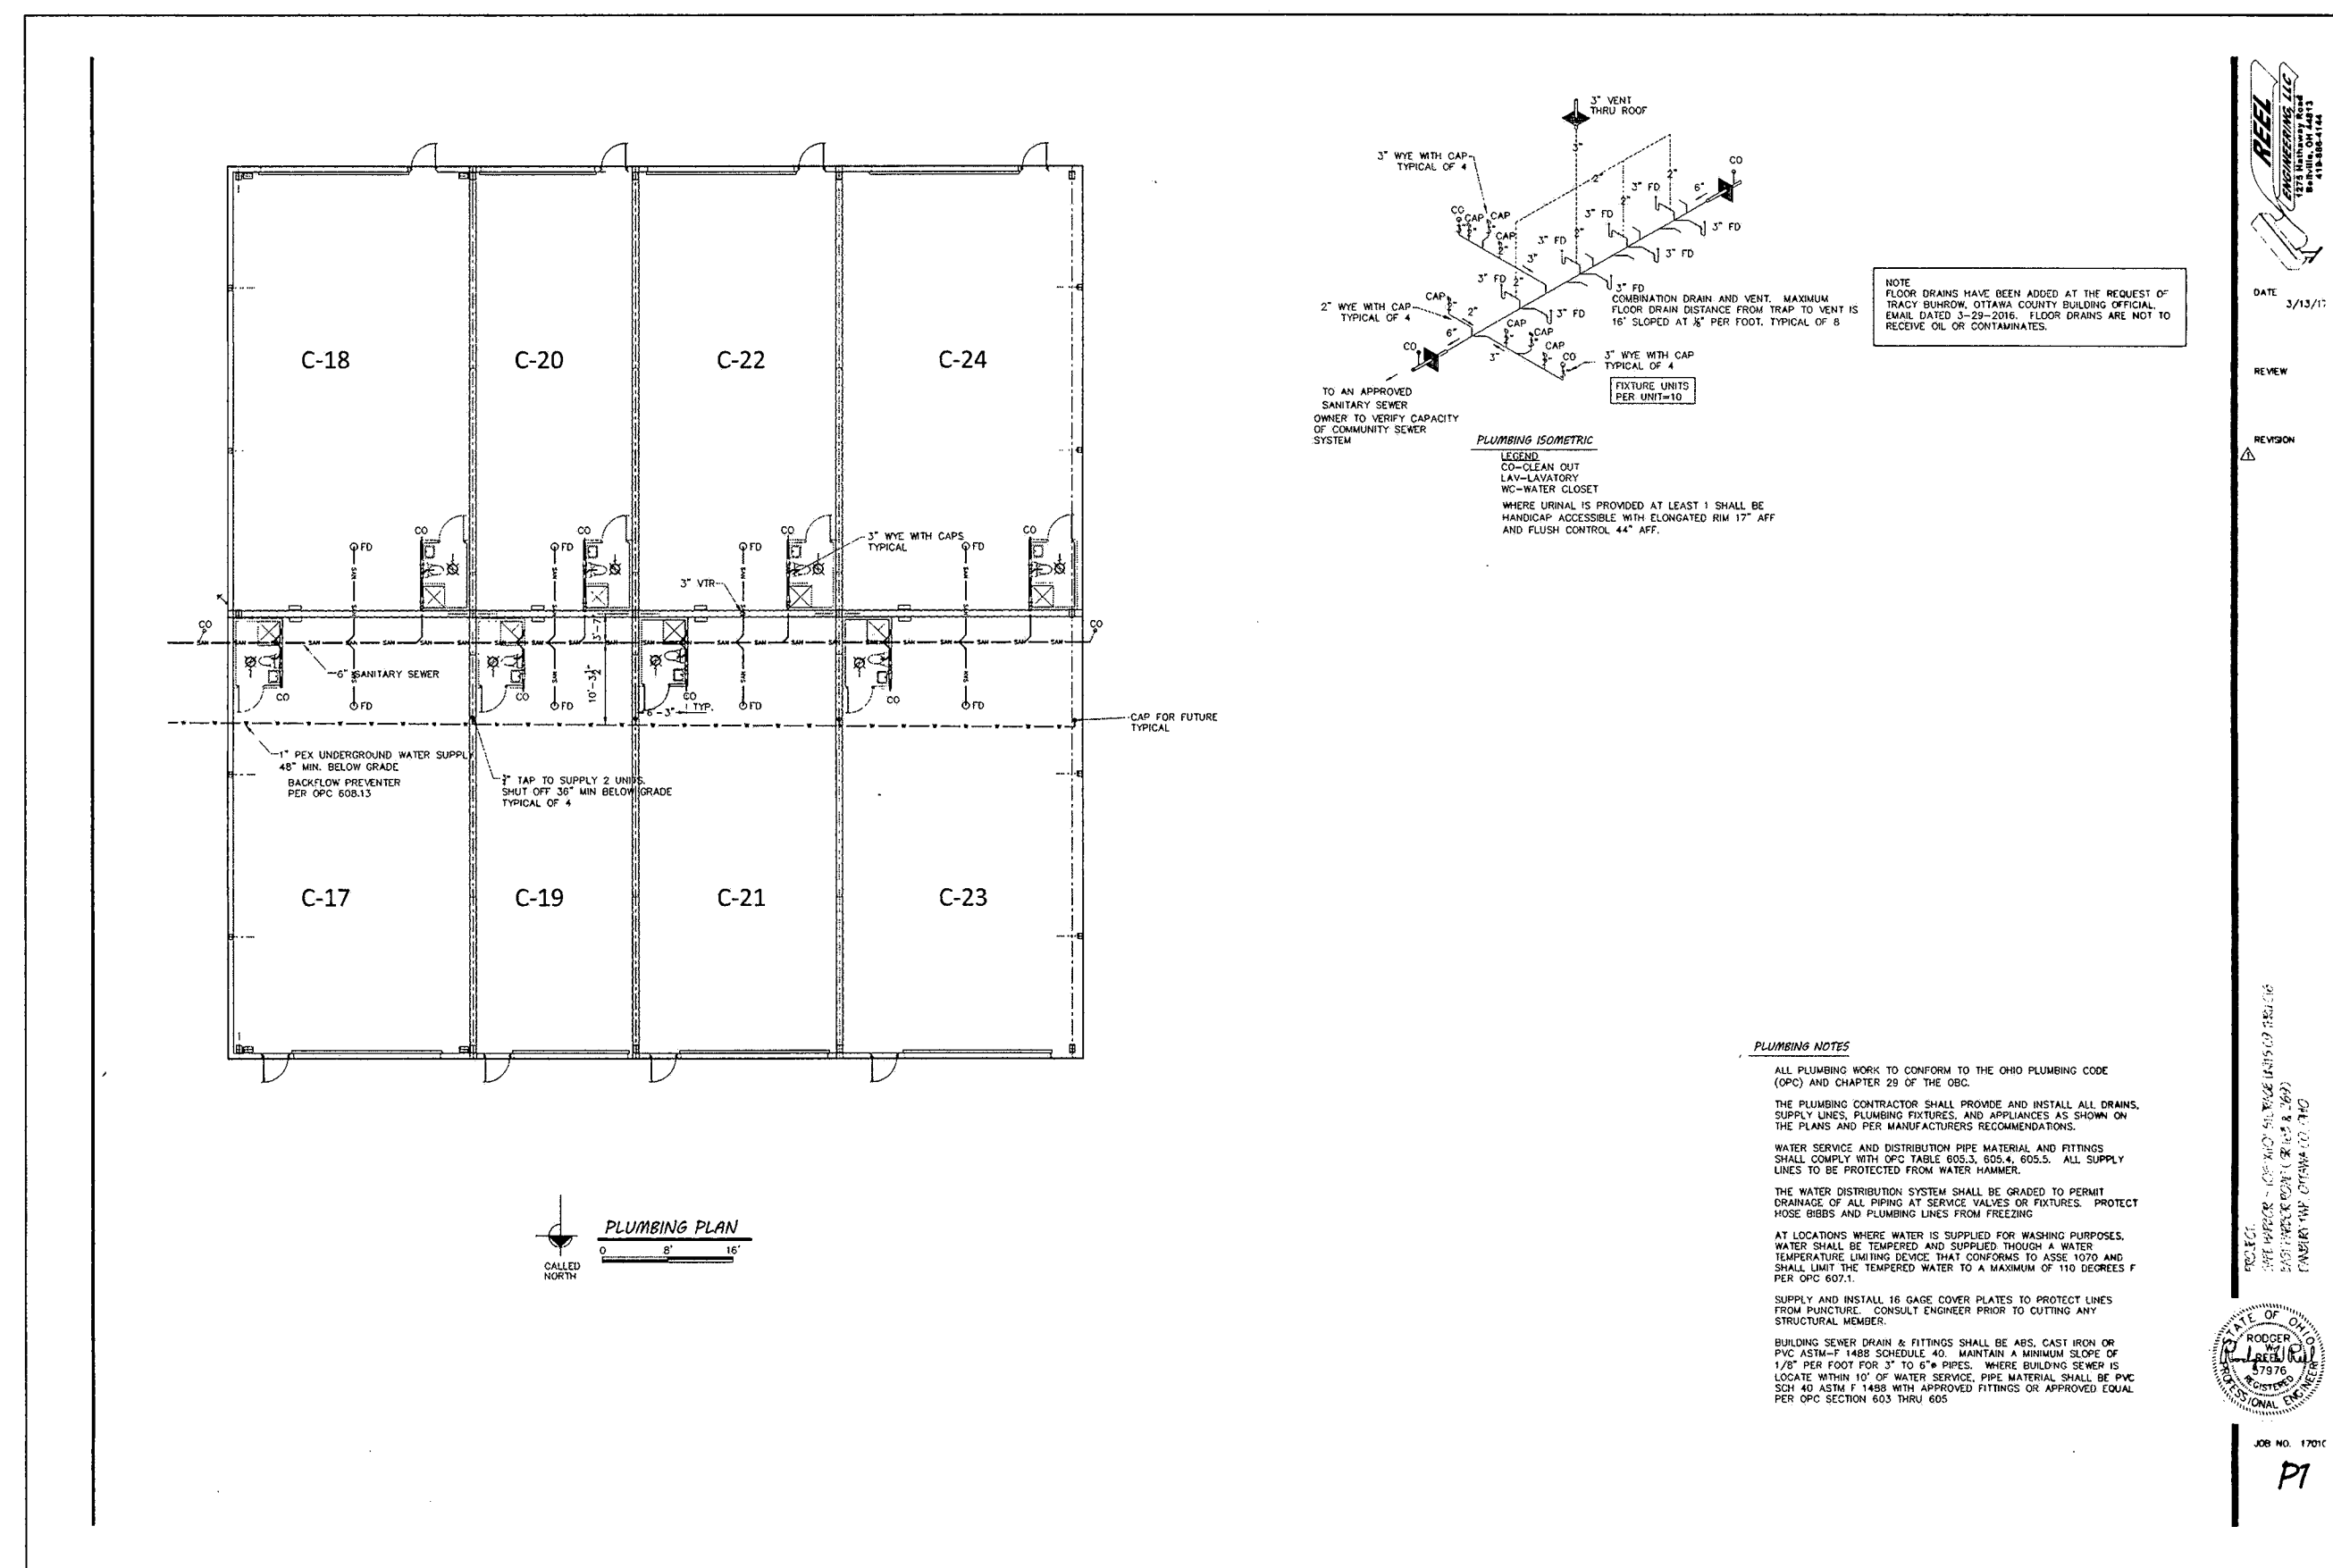

DATE: 3/13/17
 REVIEW:
 REVISION: 1
 P1

PLOTTED: Jun 19, 2018 - 8:25am
 DRAWING: M:\15080 (Safe Harbor Building Layout)\SURVEY\DWG 22-24 Safe Harbor Condominiums SEVENTH Amendment.dwg: PAGE 3



SAFE HARBOR STORAGE CONDOMINIUM SEVENTH AMENDMENT
 LOCATED IN PART OF LOT 03, SECTION 04, DANBURY TOWNSHIP, OTTAWA COUNTY, OHIO.

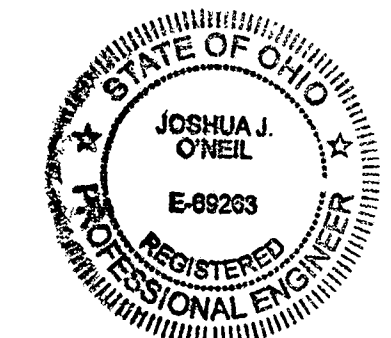

ENGINEER'S CERTIFICATION:
 I HEREBY DECLARE THAT THE DRAWING ACCURATELY SHOWS EACH BUILDING AS BUILT TO THE BEST OF MY KNOWLEDGE AND BELIEF.

Joshua J. O'Neil
 JOSHUA J. O'NEIL, P.E.
 OHIO PROFESSIONAL ENGINEER NO. 69263

DATE: 6-19-2018

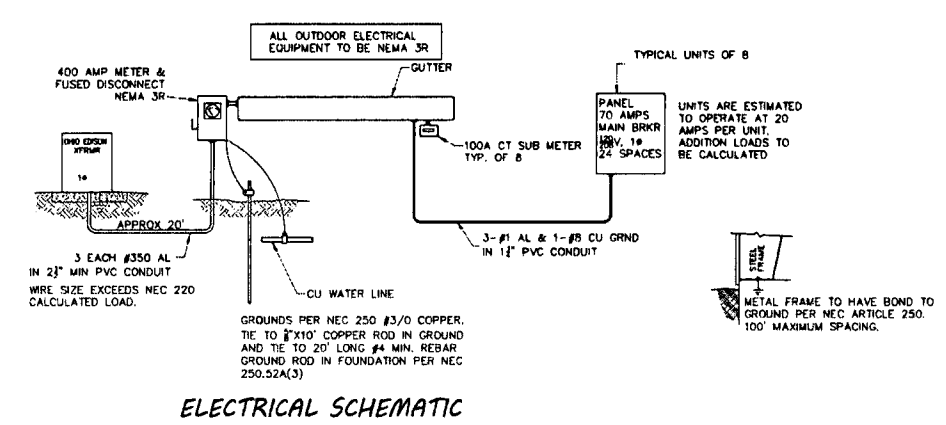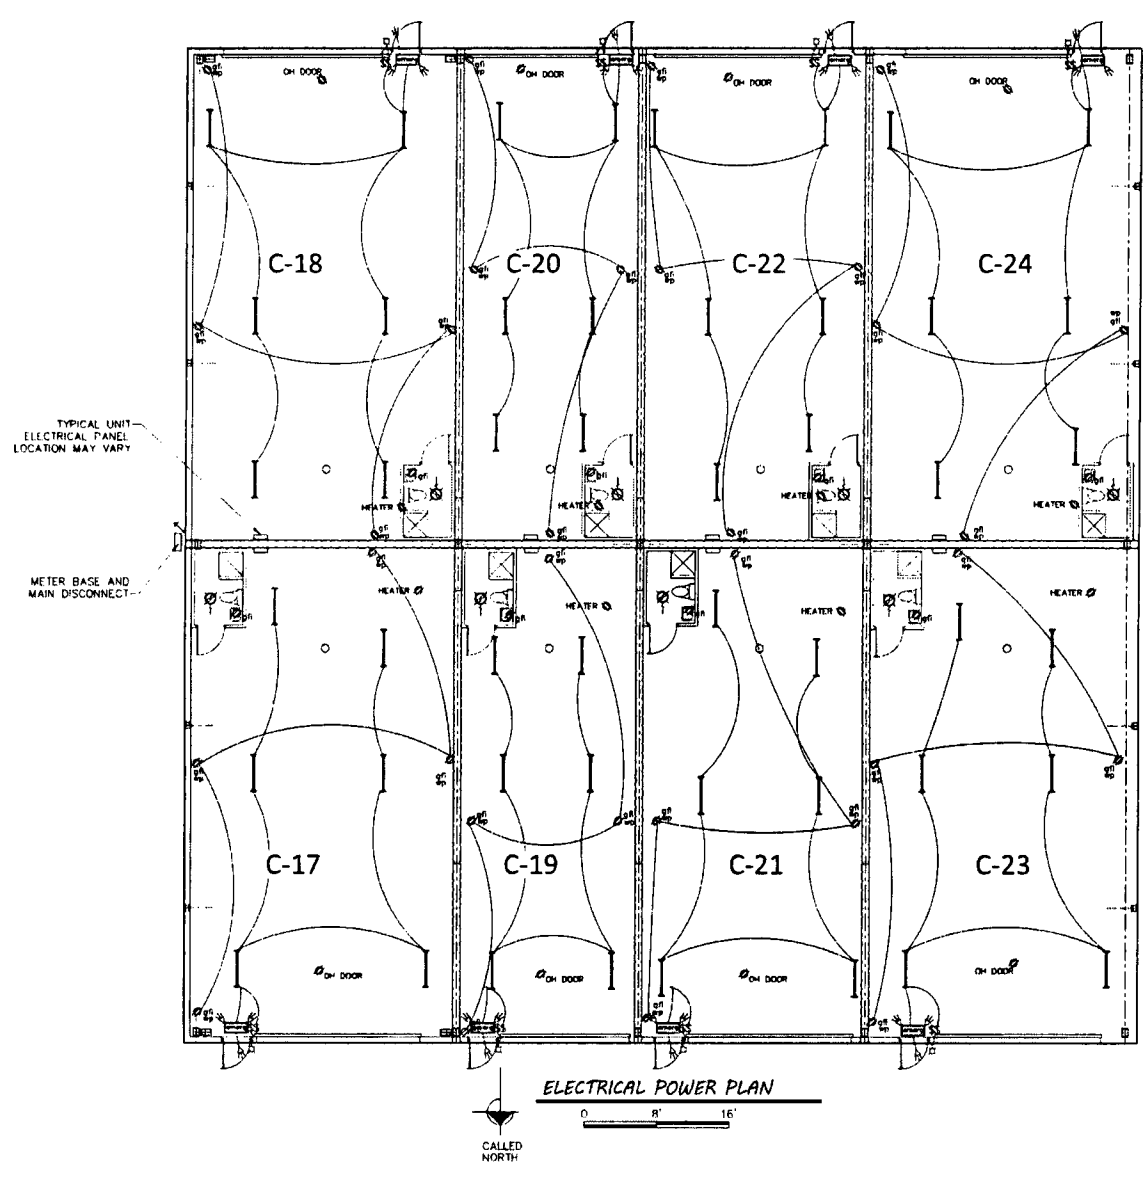

ELECTRICAL NOTES

1. ALL ELECTRICAL WORK WILL COMPLY WITH THE REQUIREMENTS OF CHAPTER 17 OF THE NATIONAL ELECTRICAL CODE (NEC) AND THE REQUIREMENTS OF THE LOCAL AUTHORITY HAVING JURISDICTION.
2. ALL WIRING SHALL BE TYPE AND SIZE AS SPECIFIED ON THIS DRAWING. ALL WIRING SHALL BE INSTALLED IN ACCORDANCE WITH THE REQUIREMENTS OF THE NATIONAL ELECTRICAL CODE (NEC) AND THE LOCAL AUTHORITY HAVING JURISDICTION.
3. ALL WIRING SHALL BE IN PVC CONDUIT UNLESS OTHERWISE SPECIFIED.
4. ALL WIRING SHALL BE INSTALLED IN ACCORDANCE WITH THE REQUIREMENTS OF THE NATIONAL ELECTRICAL CODE (NEC) AND THE LOCAL AUTHORITY HAVING JURISDICTION.
5. THE CLEARANCES REQUIRED FOR NEC SECTION 110-26 SHALL BE MAINTAINED ABOUT THE ELECTRICAL EQUIPMENT.
6. BRANCH CIRCUIT CONDUCTORS SHALL HAVE AN AMPLITUDE OF NOT LESS THAN THE MAXIMUM LOAD TO BE CARRIED. IN ADDITION, CONDUCTORS OF ALL BRANCH CIRCUITS SHALL BE PROTECTED BY OVERCURRENT DEVICES AS SPECIFIED ON THIS DRAWING.
7. BRANCH CIRCUIT CONDUCTORS AND EQUIPMENT SHALL BE PROTECTED BY OVERCURRENT DEVICES AS SPECIFIED ON THIS DRAWING.
8. LOCATE DISCONNECTS WITHIN 1' OF EQUIPMENT.



ELECTRICAL SYMBOLS

- 1 SINGLE-SWITCH SYMBOL INSTANT AT 40' HT
- 2 GROUND-FULL CURRENT INTERRUPT DUPLEX RECEPTACLE
- 3 GROUND-FULL CURRENT INTERRUPT DUPLEX RECEPTACLE WITH WATERPROOF COVER
- 4 INDUSTRIAL FLUORESCENT LIGHT FIXTURE, 2 BALLPS @ 34W 40

ELECTRICAL SCHEMATIC


DATE: 3/13/17
 REVIEW:
 REVISION:
 SHEET: E1

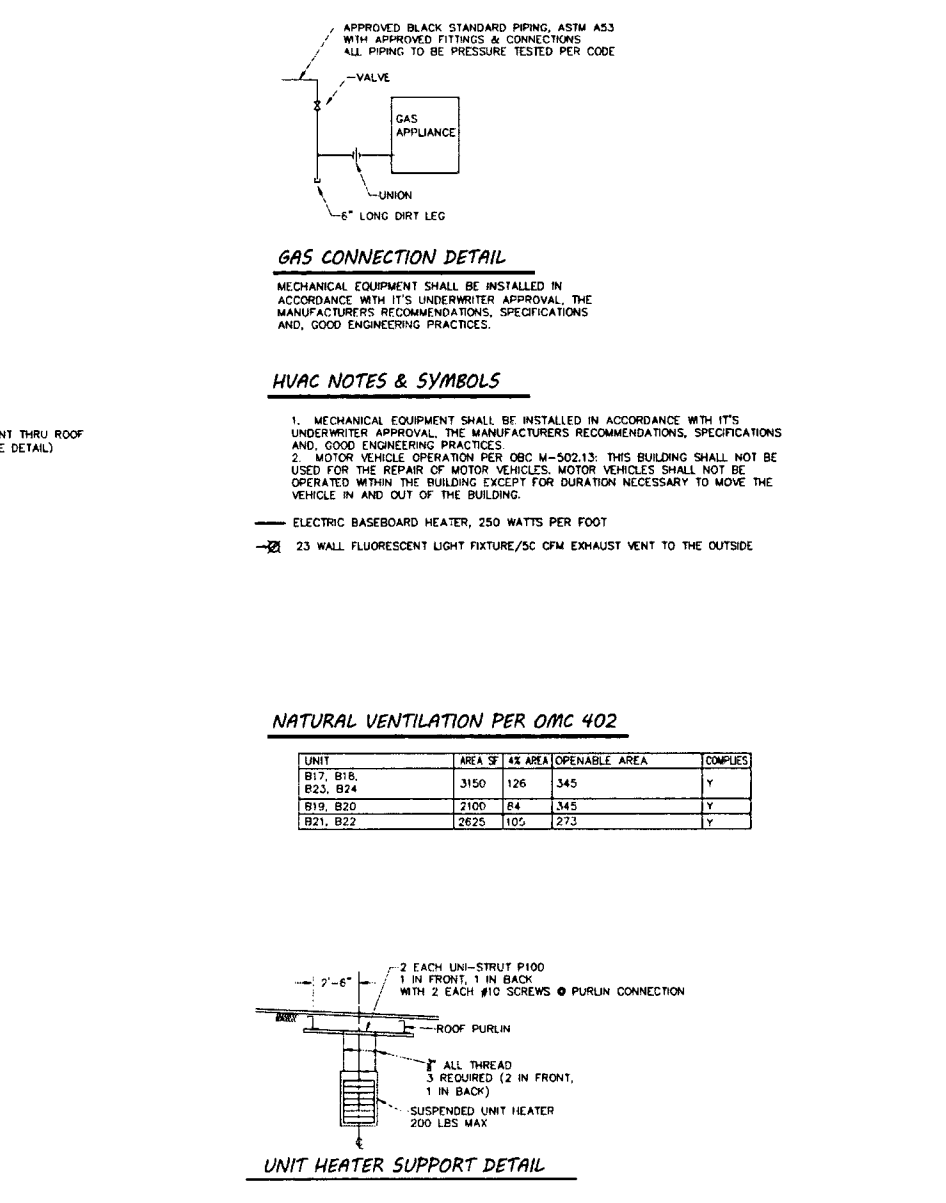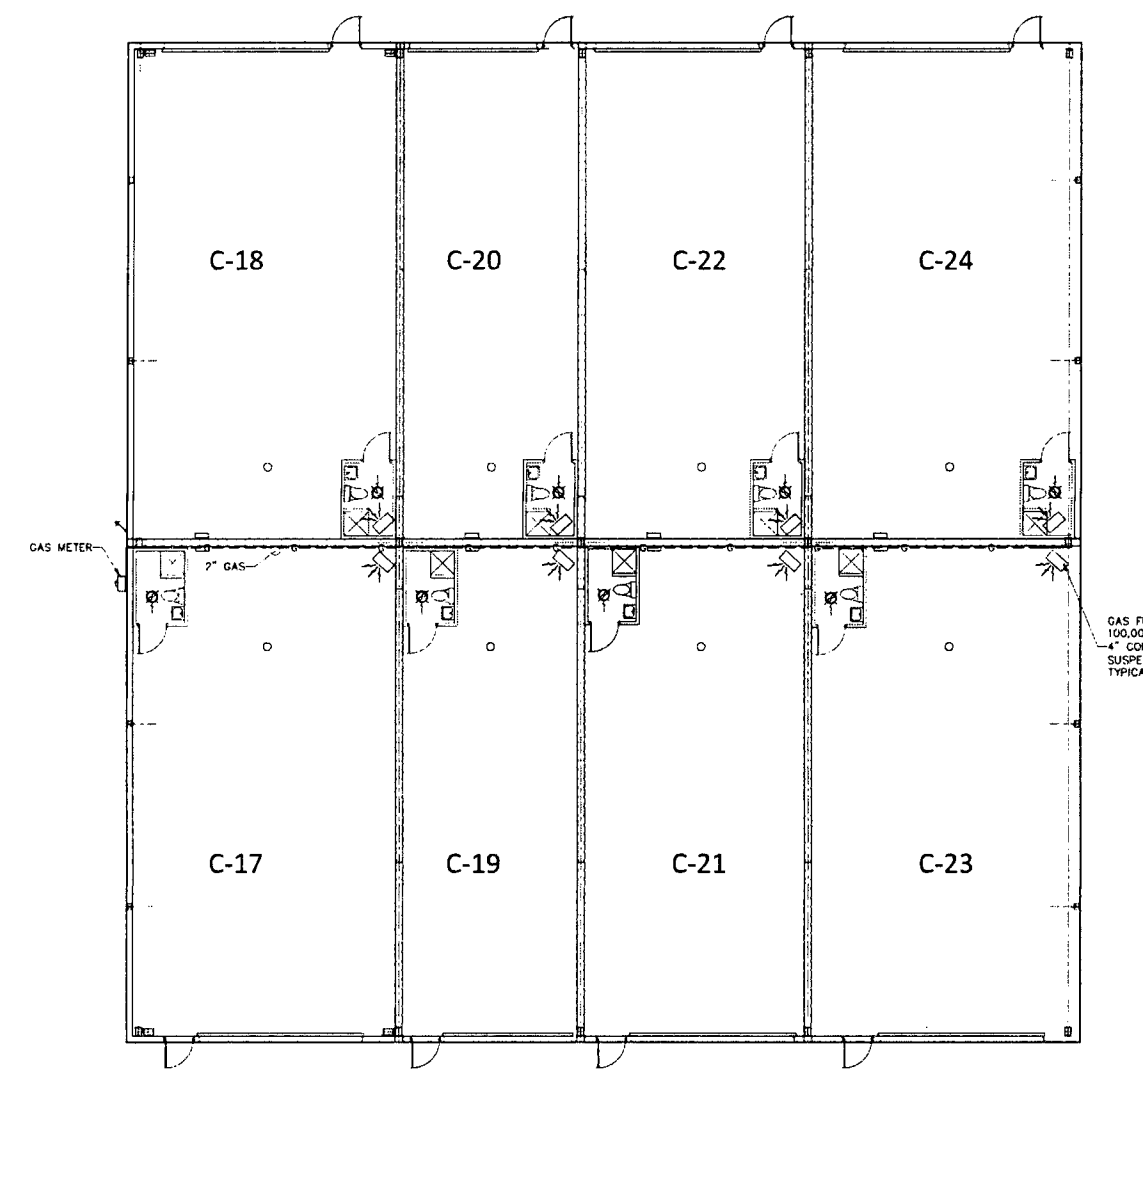

GAS CONNECTION DETAIL

MECHANICAL EQUIPMENT SHALL BE INSTALLED IN ACCORDANCE WITH ITS UNDERWRITER APPROVAL, THE MANUFACTURER'S INSTALLATION INSTRUCTIONS, SPECIFICATIONS AND GOOD ENGINEERING PRACTICES.

HVAC NOTES & SYMBOLS

1. MECHANICAL EQUIPMENT SHALL BE INSTALLED IN ACCORDANCE WITH ITS UNDERWRITER APPROVAL, THE MANUFACTURER'S INSTALLATION INSTRUCTIONS, SPECIFICATIONS AND GOOD ENGINEERING PRACTICES.

NATURAL VENTILATION PER OMC 402



UNIT HEATER SUPPORT DETAIL

 WITH 2 EACH #10 SCREWS @ PURLIN CONNECTION

DATE: 3/13/17
 REVIEW:
 REVISION:
 PROJECT: SAFE HARBOR PLAZA BUILDING LAYOUT (SURVEY) (DWG) 22x34
 SHEET: H1

PLOTTED: Jun 13, 2018 - 8:25am
 DRAWING: M:\15080 (Safe Harbor Development - Safe Harbor Plaza Building Layout)\SURVEY(Dwg)22x34 Safe Harbor Condominiums SEVENTH Amendment.dwg PAGE 4

SAFE HARBOR STORAGE
 CONDOMINIUM
 SEVENTH AMENDMENT
 LOCATED IN PART OF LOT 03 SECTION 04 DANBURY
 TOWNSHIP, OTTAWA COUNTY, OHIO.




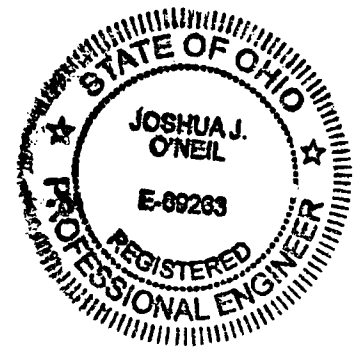


ENGINEER'S CERTIFICATION:
 I HEREBY DECLARE THAT THE DRAWING ACCURATELY SHOWS EACH BUILDING AS BUILT TO THE BEST OF MY KNOWLEDGE AND BELIEF.

Joshua J. O'Neil
 JOSHUA J. O'NEIL, P.E.
 OHIO PROFESSIONAL ENGINEER NO. 69263

DATE: 6-19-2018

PLOTTED: Jun 19, 2018 - 8:27am
 DRAWING: M:\15090 (Safe Harbor Development - Safe Harbor Plaza Building Layout)\SURVEY Dwg\22-34 Safe Harbor Condominiums SEVENTH Amendment.dwg: PAGES

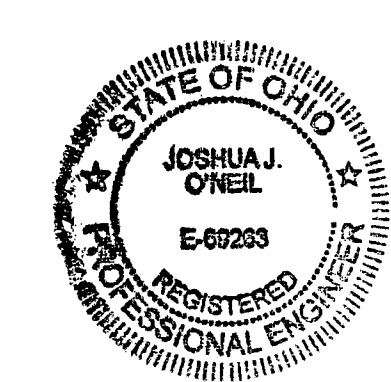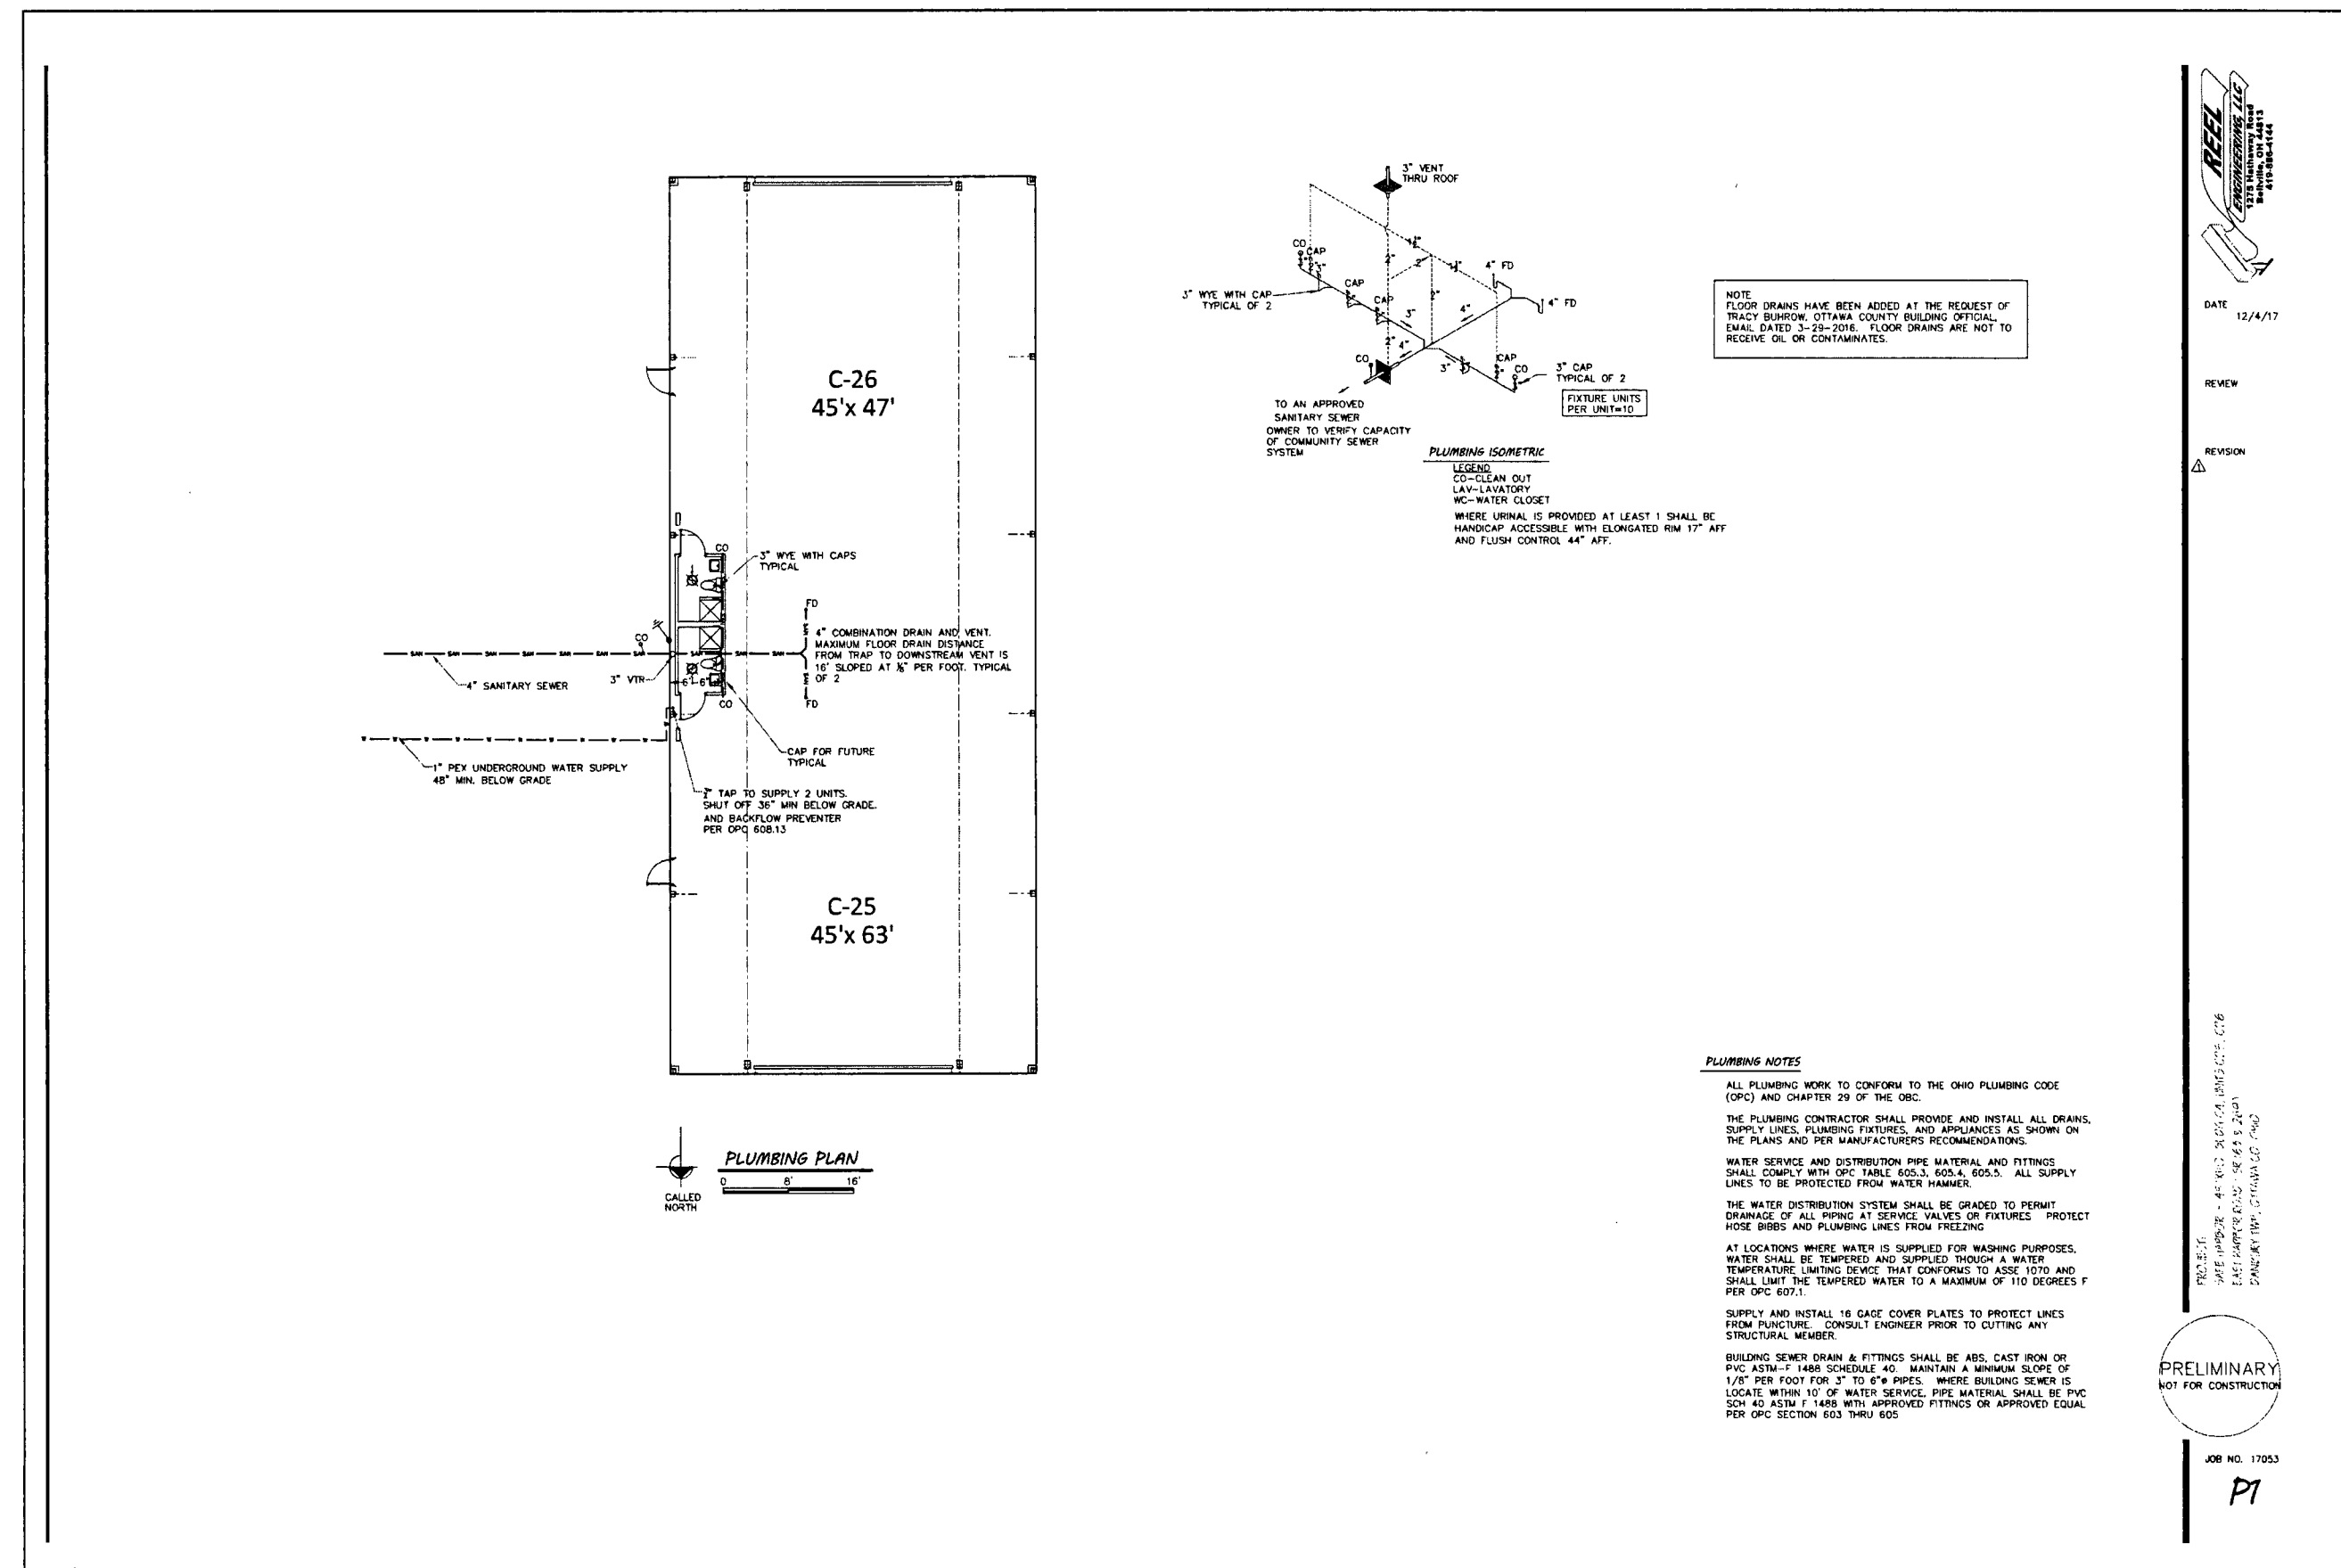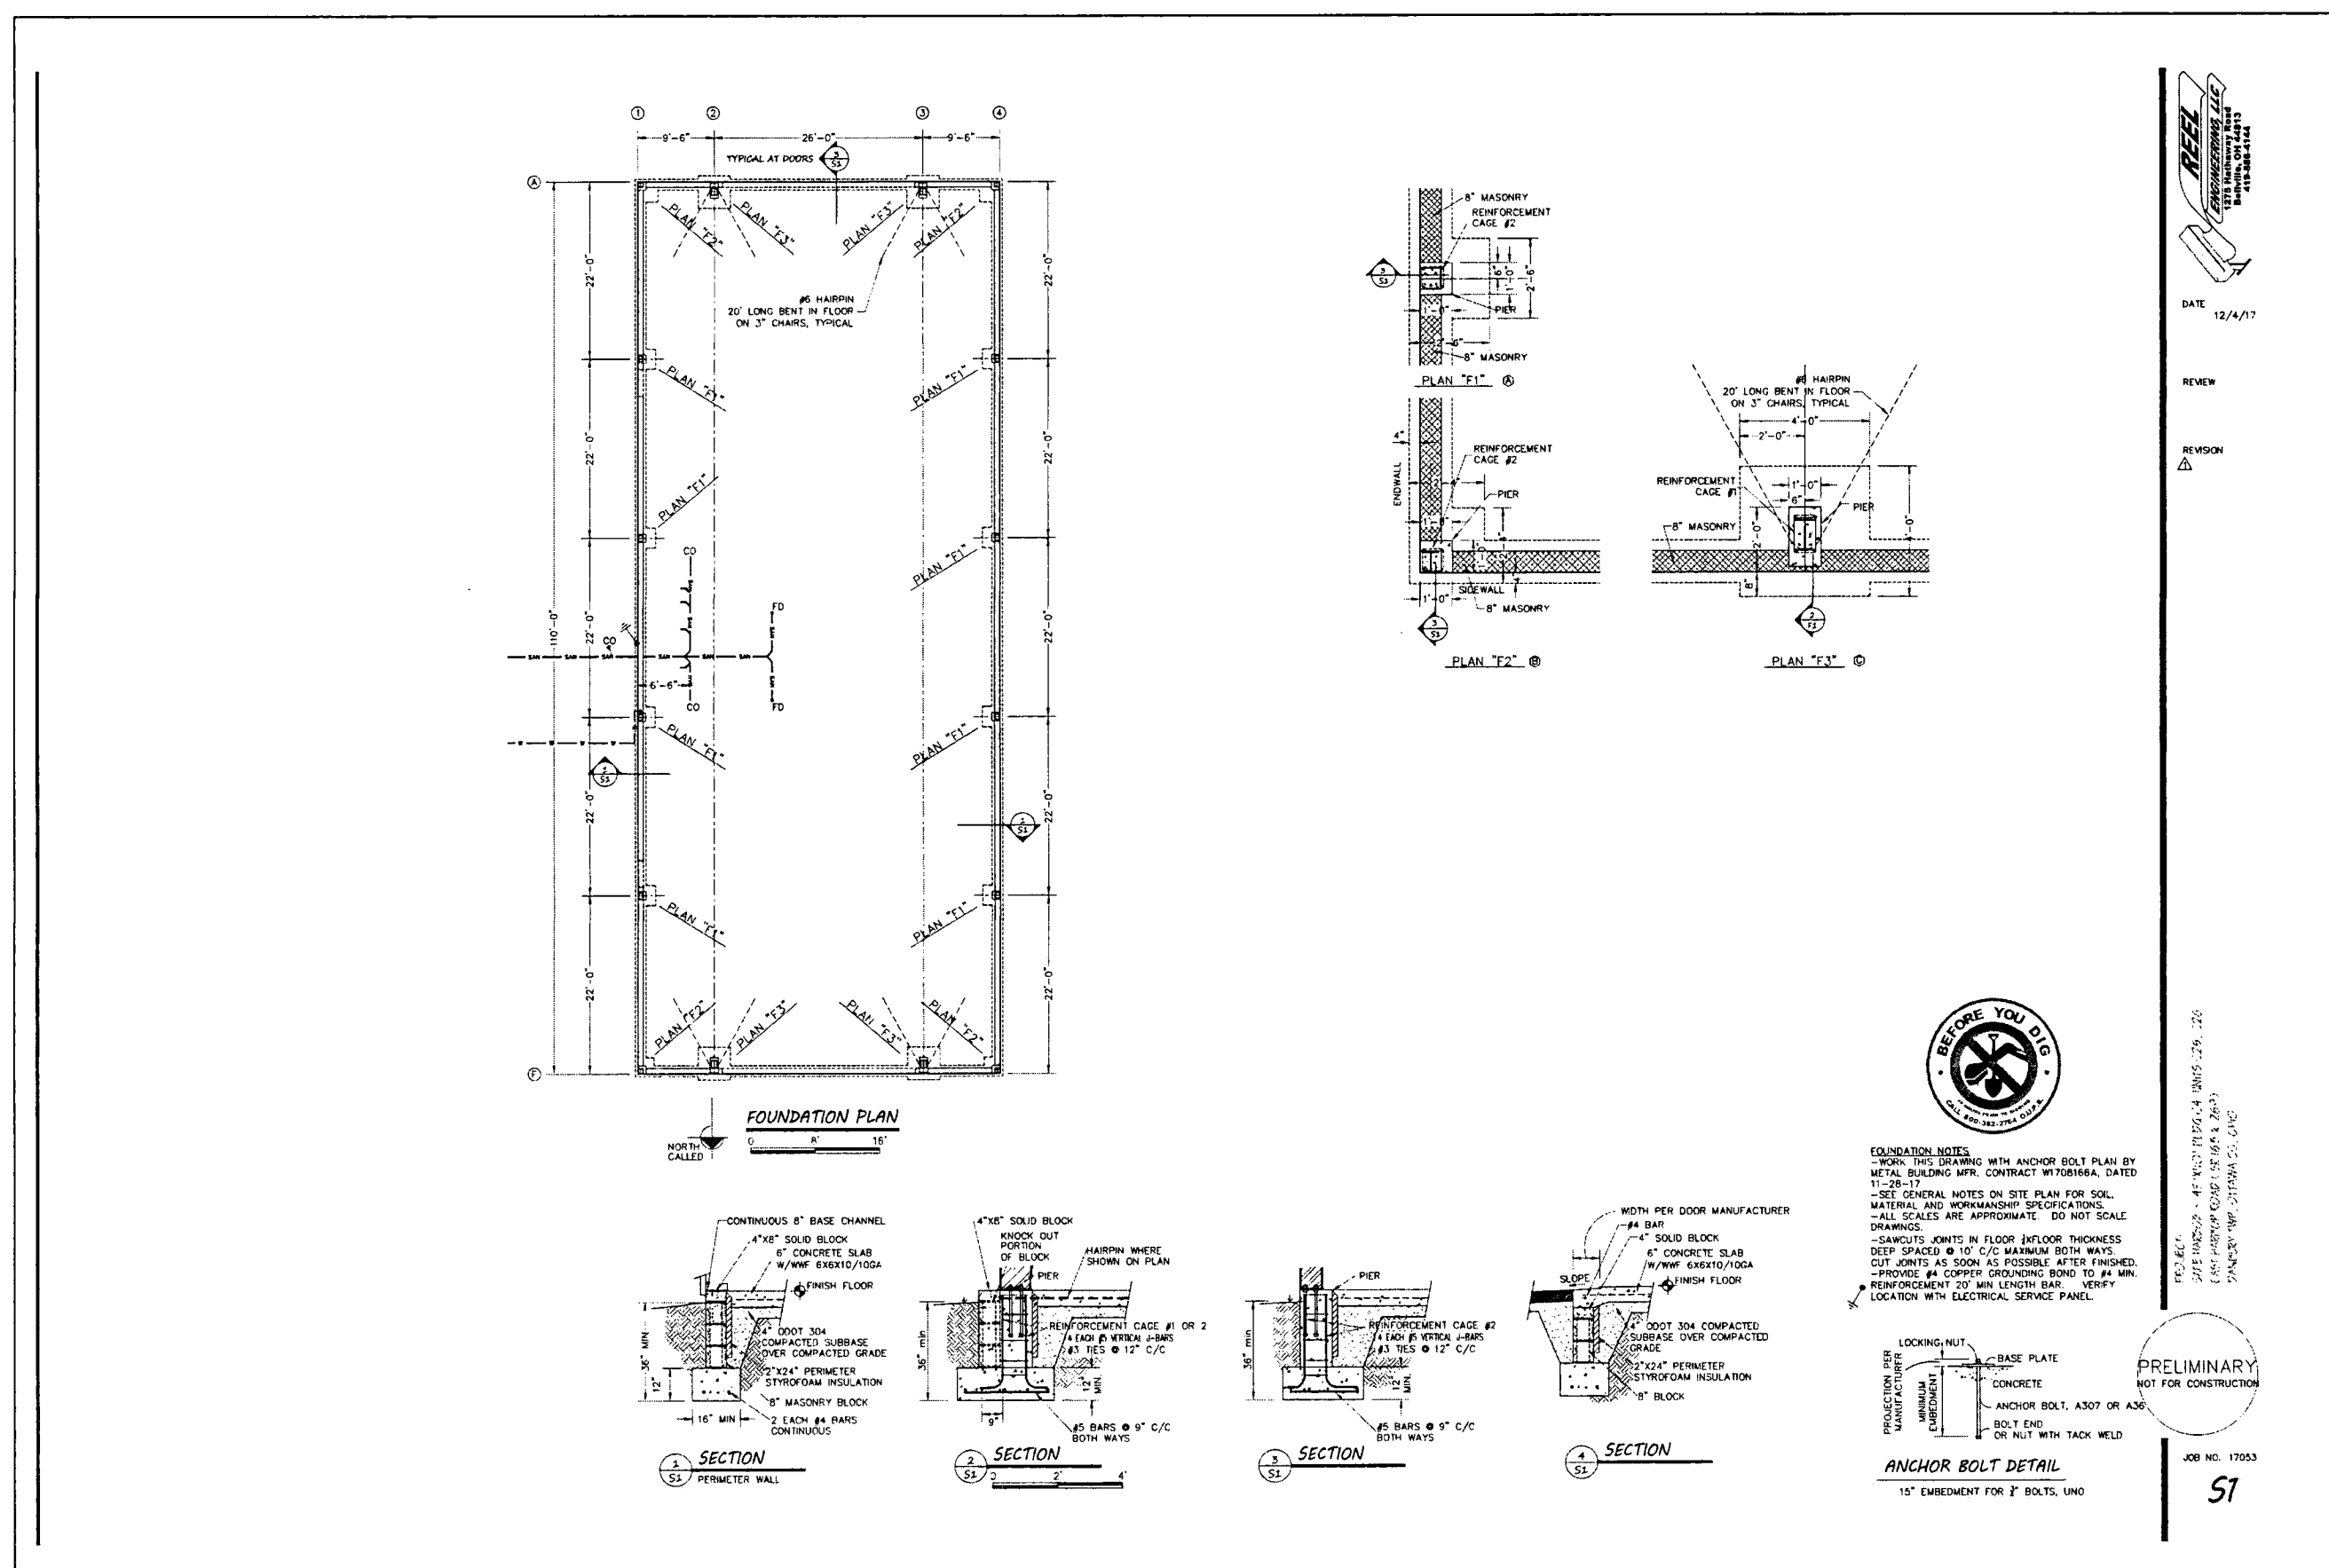
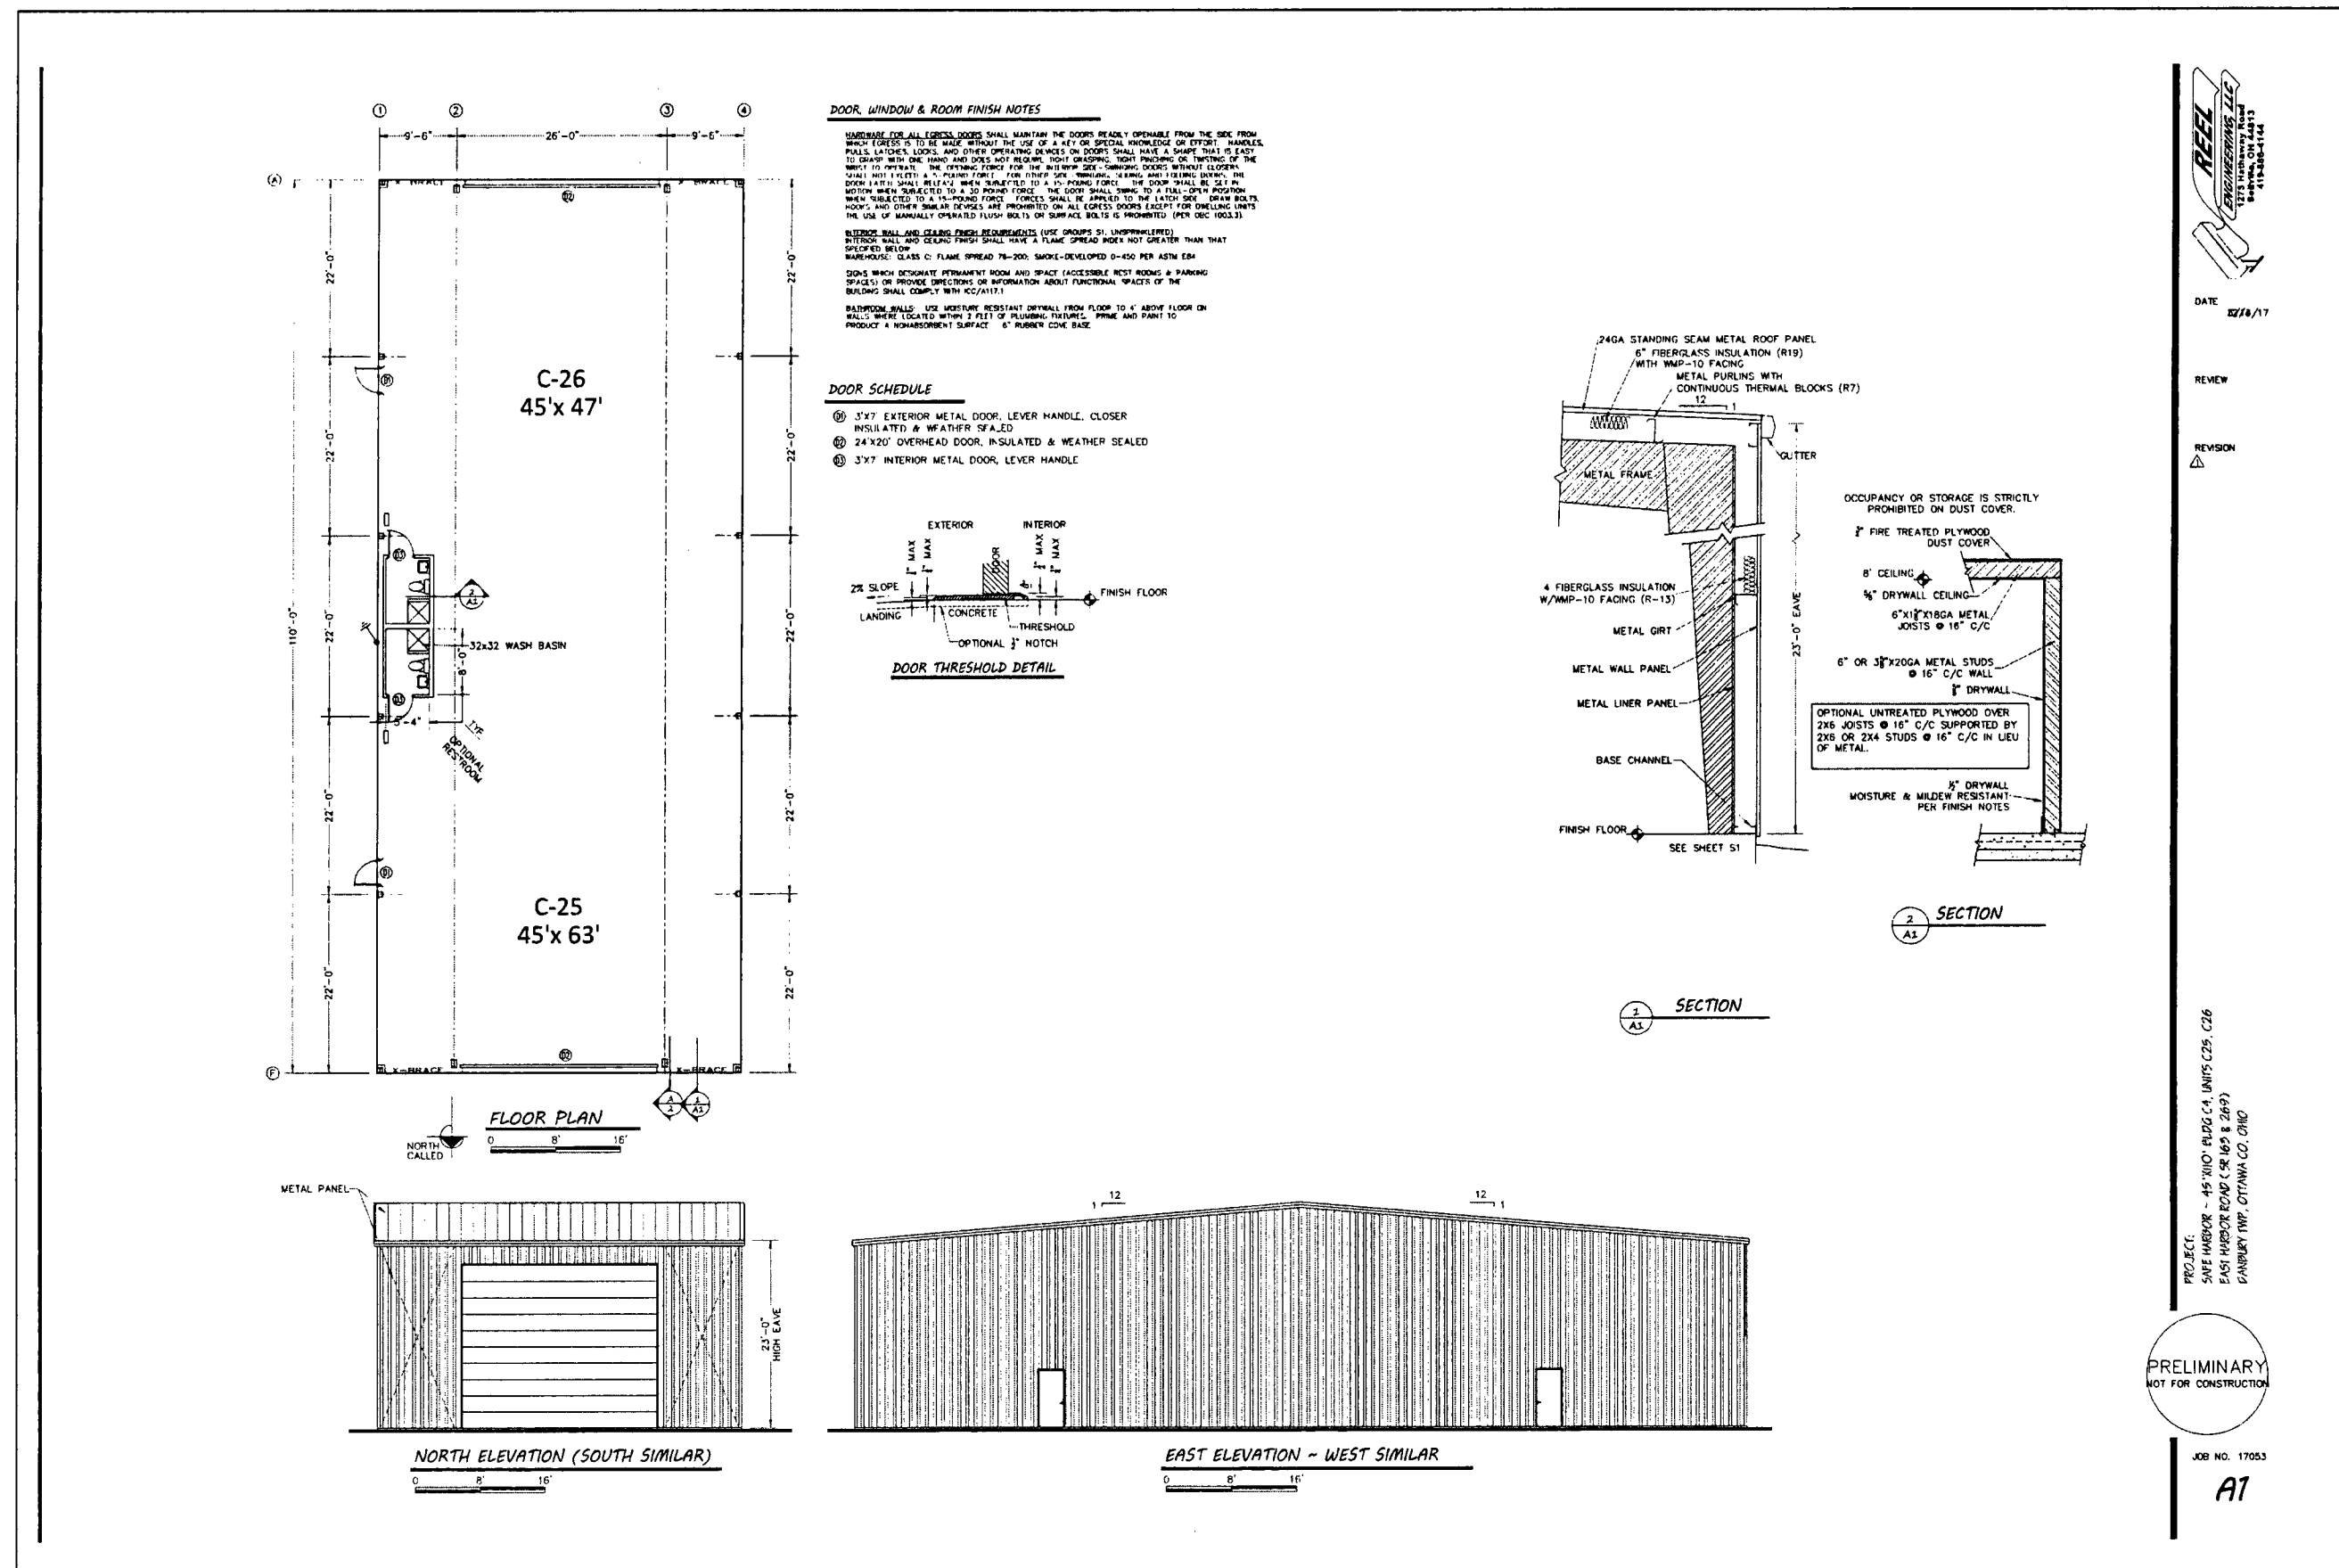


ENGINEER'S CERTIFICATION:
 I HEREBY DECLARE THAT THE DRAWING ACCURATELY SHOWS EACH BUILDING AS BUILT TO THE BEST OF MY KNOWLEDGE AND BELIEF.

Joshua J. O'Neil
 JOSHUA J. O'NEIL, P.E.
 OHIO PROFESSIONAL ENGINEER NO. 69293

6-19-2018
 DATE

SAFE HARBOR STORAGE CONDOMINIUM SEVENTH AMENDMENT
 LOCATED IN PART OF LOT 03, SECTION 04, DANBURY TOWNSHIP, OTTAWA COUNTY, OHIO.

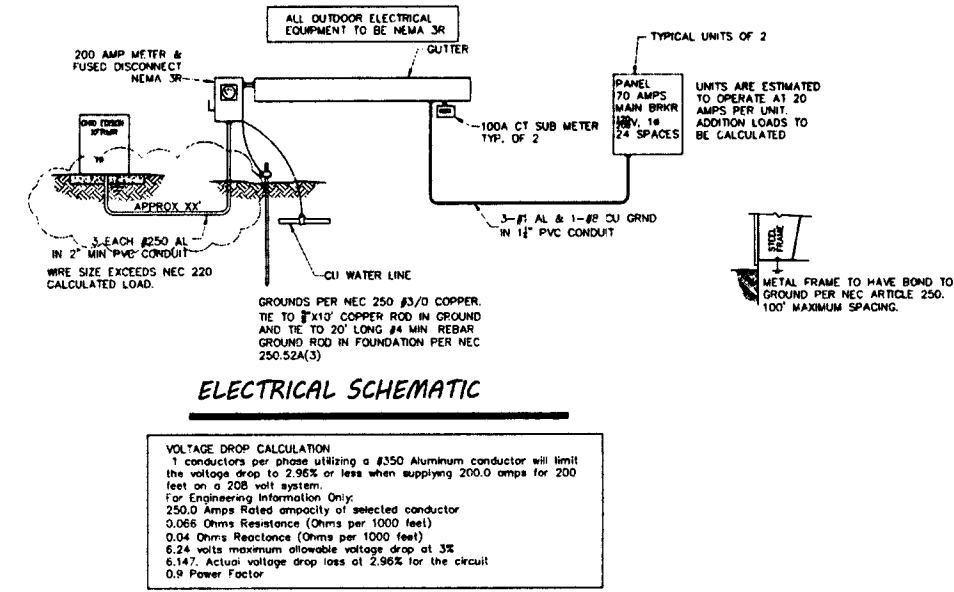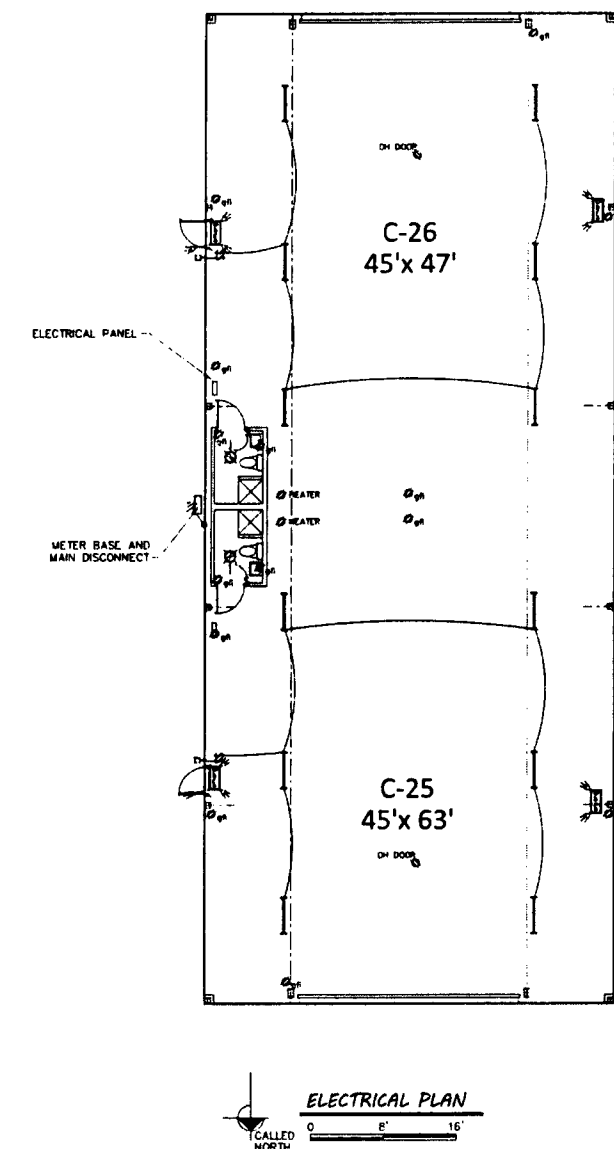

ELECTRICAL NOTES

1. ALL WIRING SHALL BE INSTALLED IN ACCORDANCE WITH THE REQUIREMENTS OF CHAPTER 47 AND THE NATIONAL ELECTRICAL CODE, AS AMENDED, AND THE NATIONAL FIRE ALARM AND SIGNAL CODE, AS AMENDED.
2. ALL WIRING SHALL BE TYPE NM-B (NONMETALLIC COPPER CONDUCTOR) UNLESS OTHERWISE SPECIFIED.
3. ALL WIRING IN DRY OR PVC CONDUIT, OPTIONAL, UNLESS OTHERWISE SPECIFIED BY NEC.
4. INTERFERING STRUCTURE REMOVAL PER NEC 210.17 SHALL BE PROVIDED FOR TELEPHONE, CABLE, SATELLITE, AND OTHER SERVICES.
5. THE CLEARANCES REQUIRED PER NEC SECTION 110-26 SHALL BE MAINTAINED ABOUT THE ELECTRICAL EQUIPMENT.
6. WIRING CIRCuits SHALL BE INSTALLED IN ACCORDANCE WITH THE REQUIREMENTS OF THE NATIONAL ELECTRICAL CODE, AS AMENDED, AND THE NATIONAL FIRE ALARM AND SIGNAL CODE, AS AMENDED.
8. LOCATE DISCONNECTS WITHIN 7' OF EQUIPMENT.



ELECTRICAL SYMBOLS

- 1 SINGLE-POLE SWITCH, MOUNT AT 48" AFF
- 2 GROUND-FULT CURRENT INTERRUPTER (GFI) RECEPTACLE
- 3 GROUND-FULT CURRENT INTERRUPTER (GFI) RECEPTACLE WITH WATERPROOF COVER
- 4 INDUSTRIAL FLUORESCENT LIGHT FIXTURE, 2 BALLS @ 30W/40
- 5 WITH REMOTE HEAD, WIRE MESH OR SHIELD
- 6 HEAD OF FLUORESCENT LIGHTING TO CONFORM TO NEC SECTION 410.10 AND 410.11 TO THE LATEST EDITION OF THE NATIONAL ELECTRICAL CODE, AS AMENDED.
- 7 200 AMP SERVICE METER
ELECTRICAL SCHEMATIC

VOLTAJE DROP CALCULATION
DATE 12/4/17
 REVIEW
 DESIGN
 PRELIMINARY NOT FOR CONSTRUCTION
 JOB NO. 17003
 ET

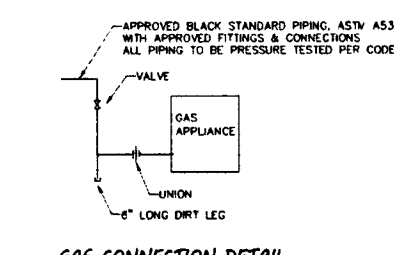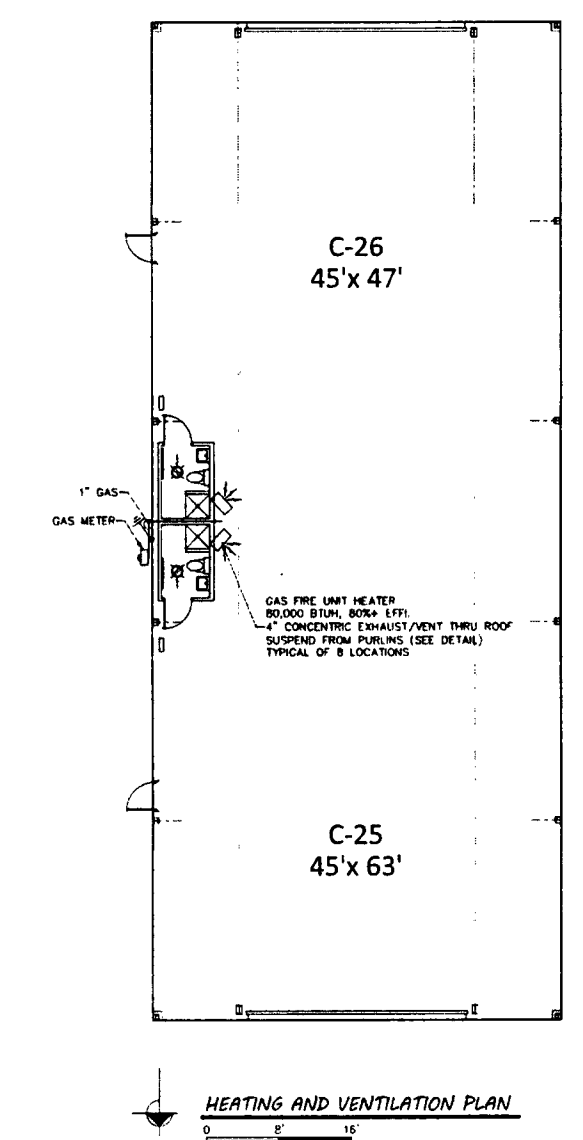


HWAC NOTES & SYMBOLS

1. MECHANICAL EQUIPMENT SHALL BE INSTALLED IN ACCORDANCE WITH ITS UNDERWRITER APPROVAL, THE MANUFACTURER'S RECOMMENDATIONS, SPECIFICATIONS AND GOOD ENGINEERING PRACTICES.
2. MOTOR VEHICLES SHALL BE INSTALLED IN ACCORDANCE WITH THE NATIONAL FIRE ALARM AND SIGNAL CODE, AS AMENDED.
3. ALL WIRING SHALL BE INSTALLED IN ACCORDANCE WITH THE REQUIREMENTS OF THE NATIONAL ELECTRICAL CODE, AS AMENDED, AND THE NATIONAL FIRE ALARM AND SIGNAL CODE, AS AMENDED.
4. LOCATE DISCONNECTS WITHIN 7' OF EQUIPMENT.

NATURAL VENTILATION PER OMC 402


UNIT	AREA OF UNITS/ROOMS AREA	COMPLY
C-26	2115	
C-25	2835	

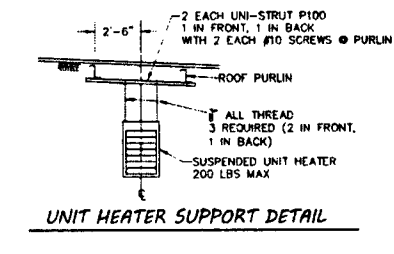

DATE 12/4/17
 REVIEW
 DESIGN
 PRELIMINARY NOT FOR CONSTRUCTION
 JOB NO. 17003
 MT

PLOTTED: Jun 19, 2018 - 8:28am
 DRAWING: M:\5000 (Safe Harbor Building Layout)\SURVE\Draw\22-34 Safe Harbor Condominiums SEVENTH Amendment.dwg: PAGES

SAFE HARBOR STORAGE
 CONDOMINIUM
 SEVENTH AMENDMENT
 LOCATED IN PART OF LOT 03, SECTION 04, DANBURY
 TOWNSHIP, OTTAWA COUNTY, OHIO.

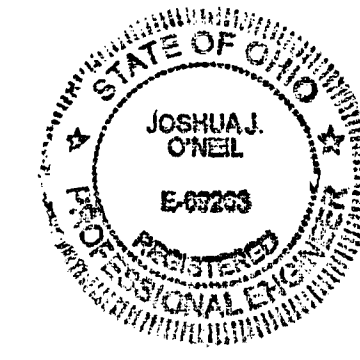

ENGINEER'S CERTIFICATION:
 I HEREBY DECLARE THAT THE DRAWING ACCURATELY SHOWS EACH BUILDING AS BUILT TO THE BEST OF MY KNOWLEDGE AND BELIEF.
 Joshua J. O'Neil
 6.19.2018
 DATE
 JOSHUA J. O'NEIL, P.E.
 OHIO PROFESSIONAL ENGINEER NO. 69263