
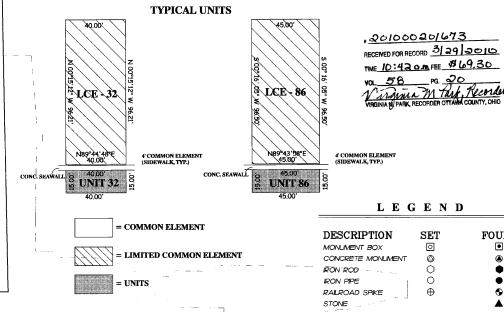


MARITIME SHOREWAY (50' R/W)

(20' INGRESS/EGRESS EASEMENT TO LUMAC DEVELOPMENT COMPANY IN DEED VOL. 261, PG. 551)

# West Harbor Lagoons Boataminium Condominium

BEING PART OF LOT 16 OF THE FIRELANDS SURVEY,  
SECTION 3, DANBURY TOWNSHIP, OTTAWA COUNTY, OHIO.

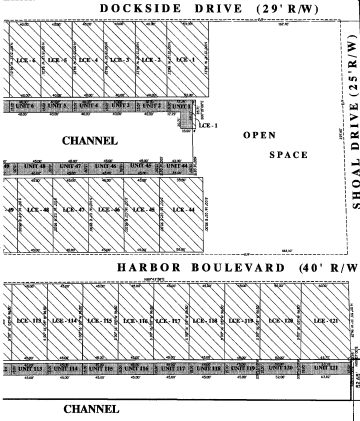

**SURVEYOR'S CERTIFICATION**


I HEREBY DECLARE THAT THE DRAWING ACCURATELY REPRESENTS THE LOCATION OF IMPROVEMENTS AND RECORDED EASEMENTS TO THE BEST OF MY KNOWLEDGE AND BELIEF.

*[Signature]* 3/25/2010 DATE

**ENGINEER'S CERTIFICATION**

I HEREBY CERTIFY THAT THE DRAWING ACCURATELY SHOWS EACH WATER SHIP CONSTRUCTED TO THE BEST OF MY KNOWLEDGE AND BELIEF.

*[Signature]* 3/25/2010 DATE

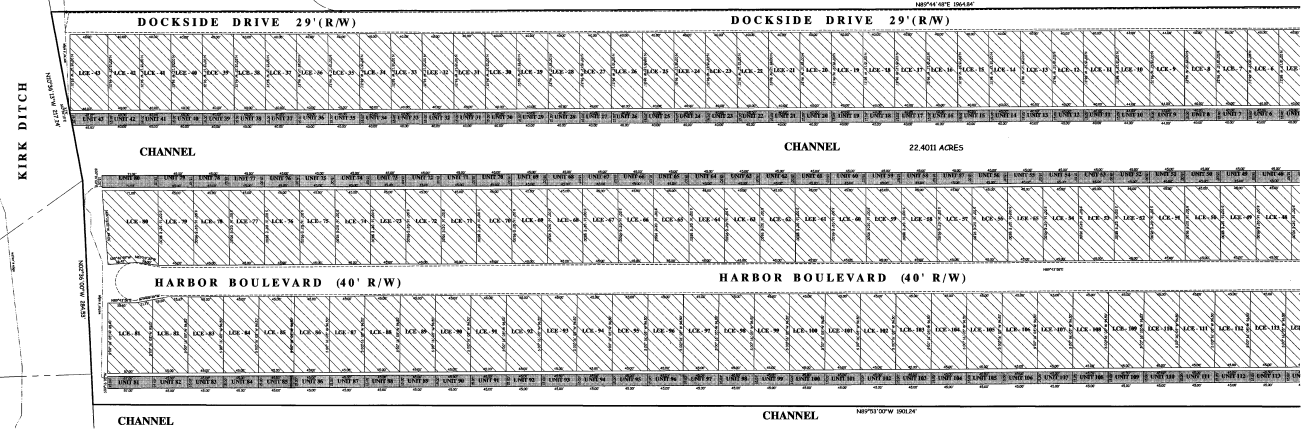



FINAL PLAT

**KUSMER & ASSOCIATES, INC.**  
SURVEYORS  
ENGINEERS

**WEST HARBOR LAGOONS BOATAMINIUM CONDOMINIUM**  
BEING PART OF LOT 16 OF THE FIRELANDS SURVEY, SECTION 3, DANBURY TOWNSHIP, OTTAWA COUNTY, OHIO.

Checked: 03/25/2010  
Reviewed: 03/25/2010  
Date: 03/25/2010  
Scale: 1" = 500'

1/1