
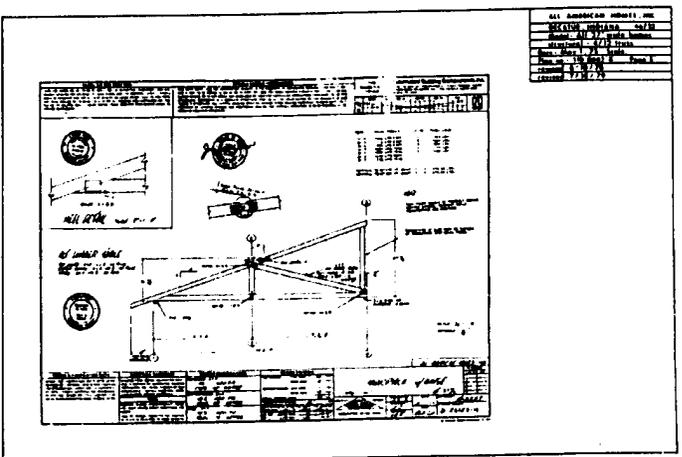
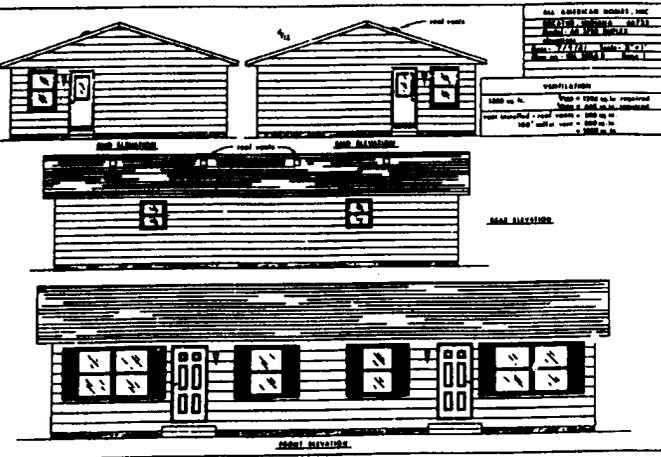
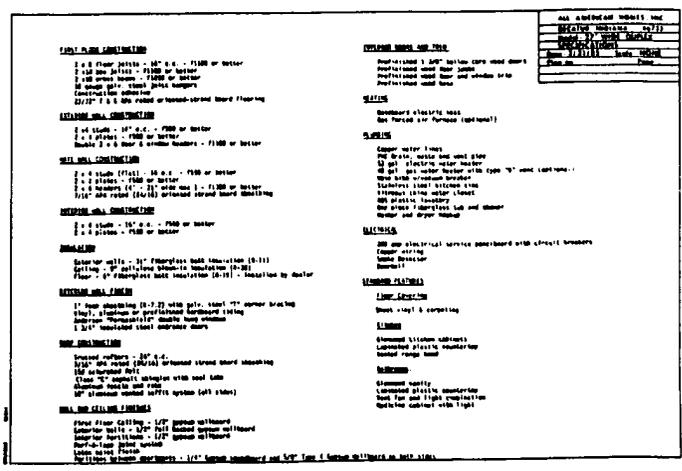
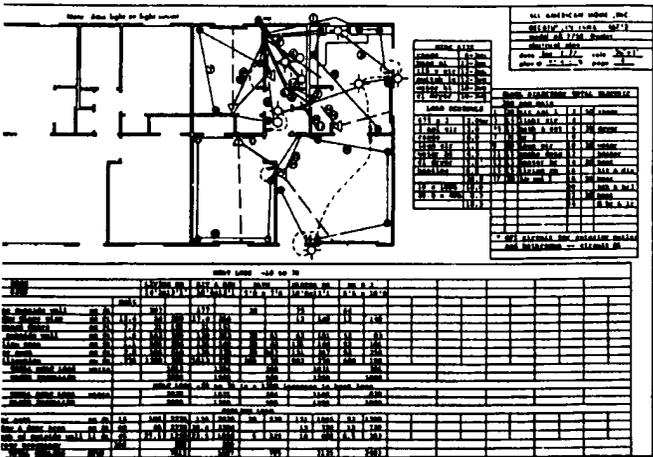


G.A.R.C.E.S. CONSULTING  
 22 S. SANDUSKY DELAWARE, OHIO 44824

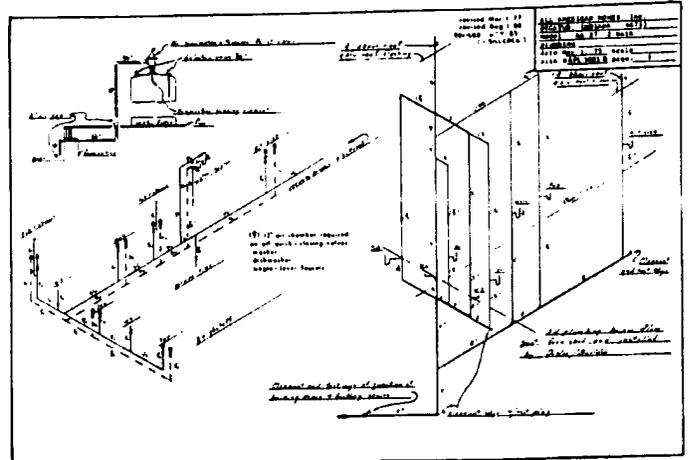

1/4" = 1'-0" TO INDICATE POSITION  
 REVISIONS: CORRECTED DRAWING  
 REVISIONS: CORRECTED DRAWING  
 REVISIONS: CORRECTED DRAWING  
 REVISIONS: CORRECTED DRAWING







VOL. 22 NO. 510

The drawings accurately show the buildings as constructed.

SEAL

SEAL

*David A. Brukhorst*  
 David A. Brukhorst, P.E., R.S.  
 Professional Engineer 119410  
 Registered Surveyor 26314

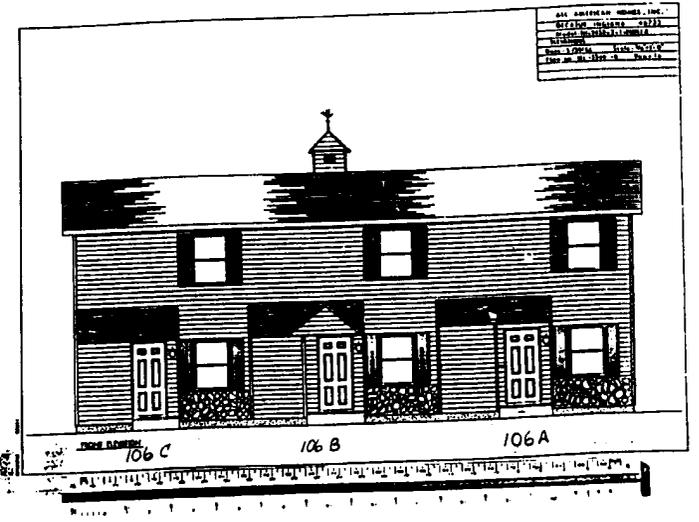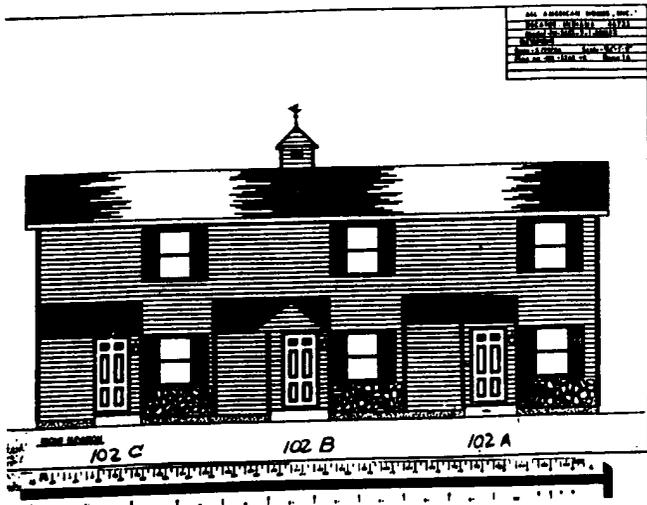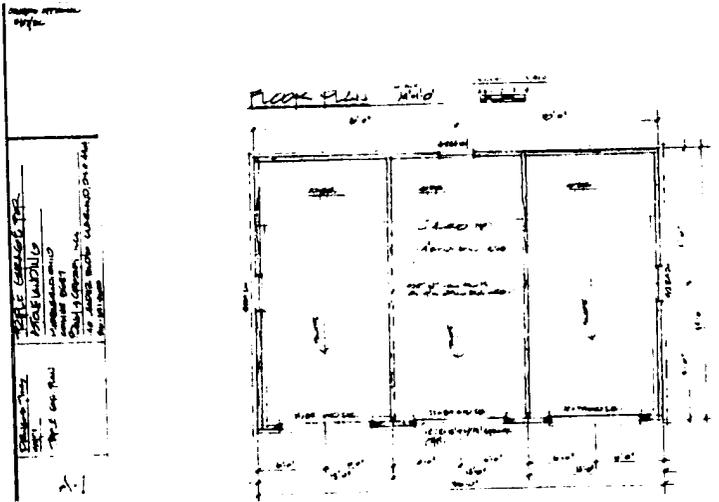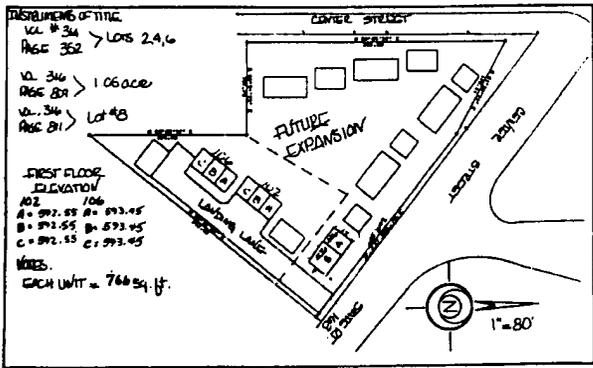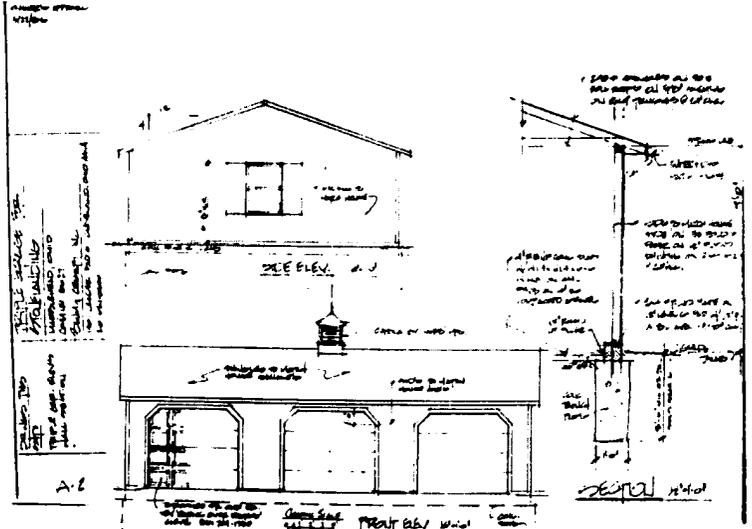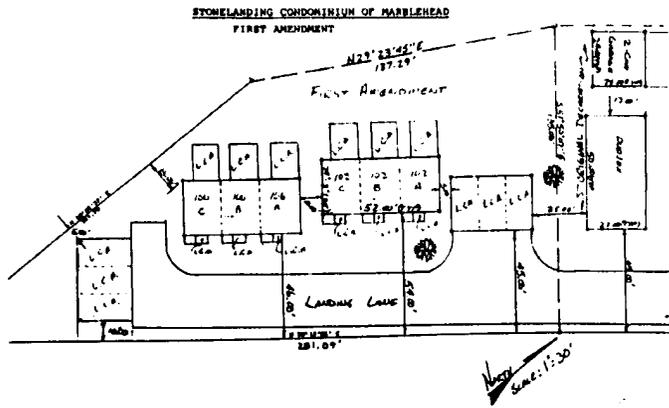

VOL. 22 PG. 9-C

GARBER'S  
 PRINTING NOVELTIES OFFICE FURNITURE  
 22 S. SANDUSKY DELAWARE, OHIO 44870





