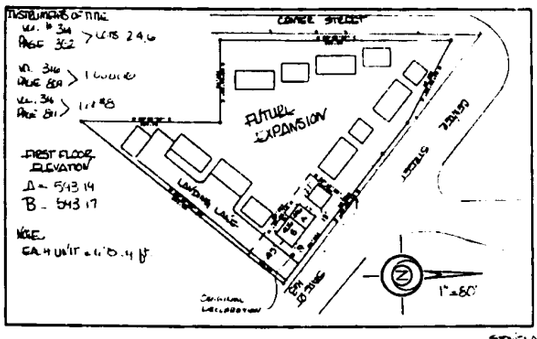

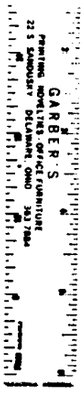

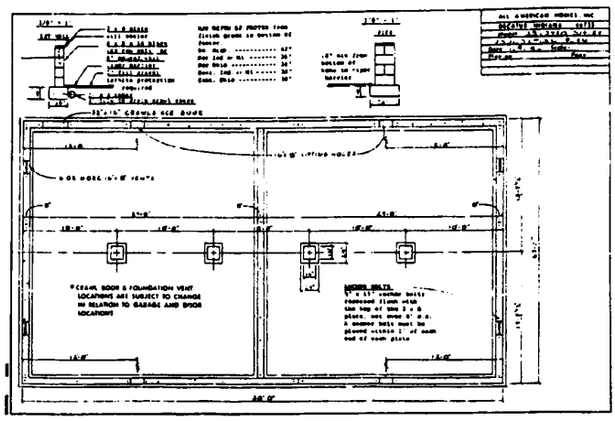

The drawings accurately show the buildings as constructed.

David A. Brunkhorst, P.E., R.S.
Professional Engineer #19610
Registered Surveyor #6314

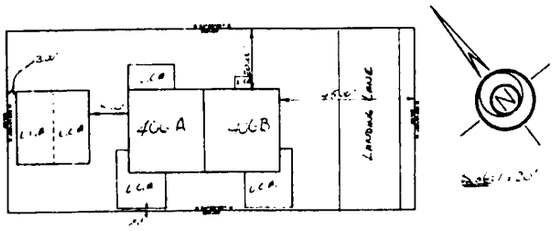

Stone Landing Condominium Master Deed
Original Declaration

SEAL

SEAL

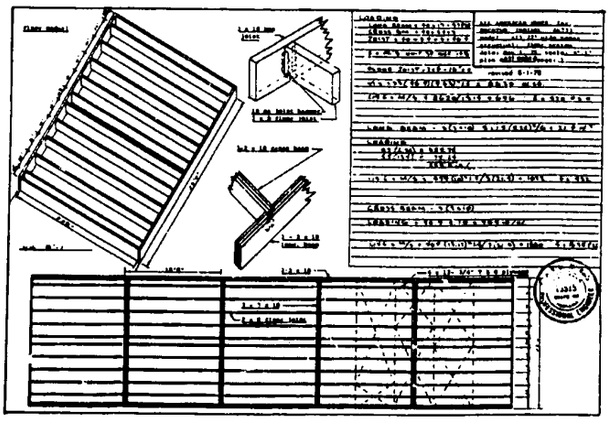

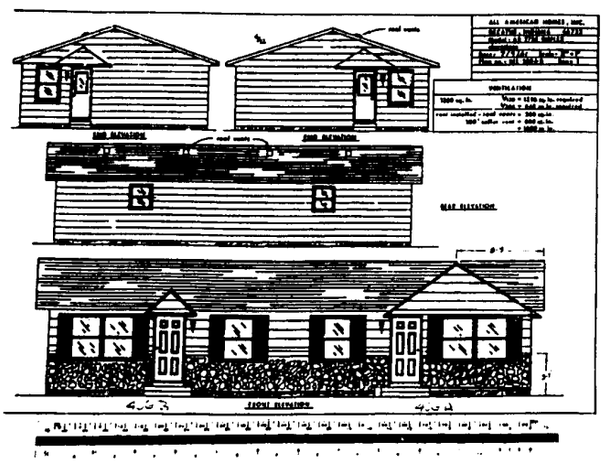

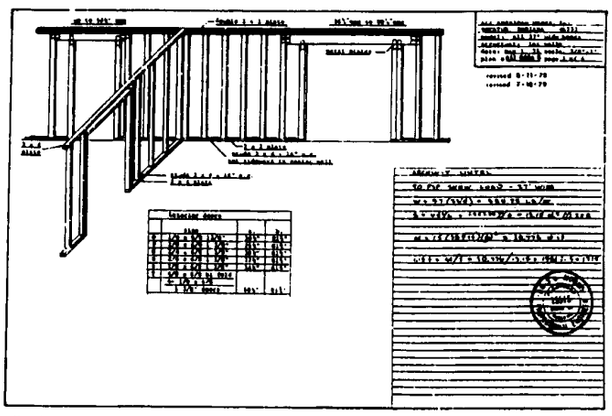

#24807 Re-Recording of Plat Map
Received: October 8, 1986 11:36 a.m.
Recorded: October 9, 1986
Vol. 22 Pg. 9 Fee $34.80
William A. Kessler Recorder

Vol. 22 Pg. 9