

# OTTAWA COUNTY ENGINEERS OFFICE

REFERENCE NO. 10-6-14-A  
NW CORNER POST SECTION 10  
HARRIS TWP.

SHEET 1 OF 1.

**PERSONNEL:**

M. WITTMAN, P.S.  
E. KOCH  
C. MILLER

**DATE / WEATHER / TEMP:**

JULY 1, 2009  
CLOUDY W  
68° F

ROUTE: T-21 STANGE RD.

TOWNSHIP: HARRIS


SECTION: 10

T 6 NR 14 E.

NORTHING:


EASTING:

DATUM:

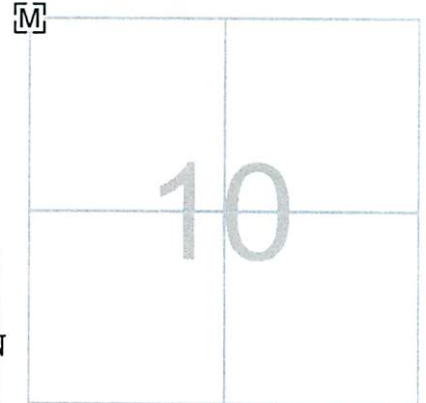

MONUMENT INFORMATION

MONUMENT TYPE: FD 1 1/4" SQ. IRON PIN IN  
MONUMENT BOX  
ON SURFACE - BELOW: 0.10'  
LEFT - CL PAVT - RIGHT: 7.40'

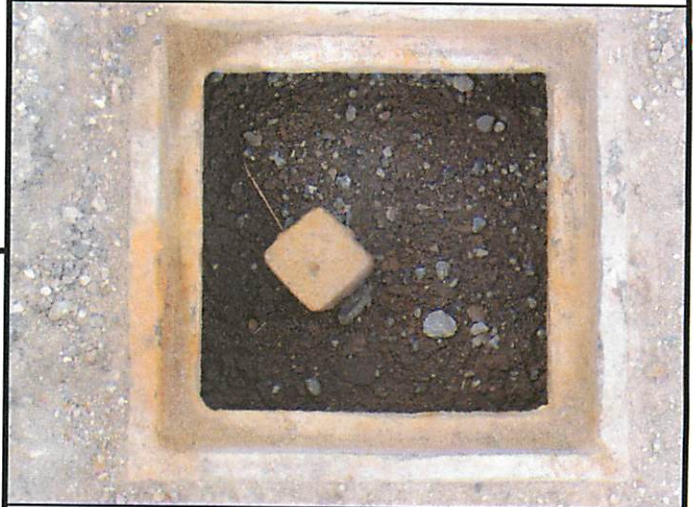

MISC. INFORMATION

MONUMENT BOX IS IN LINE WITH EAST EDGE OF  
PAVEMENT.

