

# OTTAWA COUNTY ENGINEERS OFFICE

REFERENCE NO. 16-6-14-A  
NW CORNER POST SEC. 16  
HARRIS TWP.  
SHEET 1 OF 1.

ROUTE: T-46 LINKER-PORTAGE RD.

TOWNSHIP: HARRIS

SECTION: 16

T 6 NR 14 E.


NORTHING:

EASTING:

DATUM:


PERSONNEL:  
M. WITTMAN, P.S.  
J. ALLEN

DATE / WEATHER / TEMP:  
APRIL 24, 2012  
SUNNY N-NW  
56° F

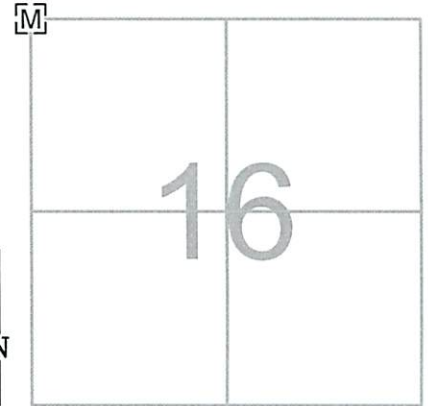

## MONUMENT INFORMATION

MONUMENT TYPE: FD 1" SQ. IRON PIN IN MON. BOX  
ON SURFACE - BELOW: 0.16'  
LEFT - CL PAV'T - RIGHT: 0.45'

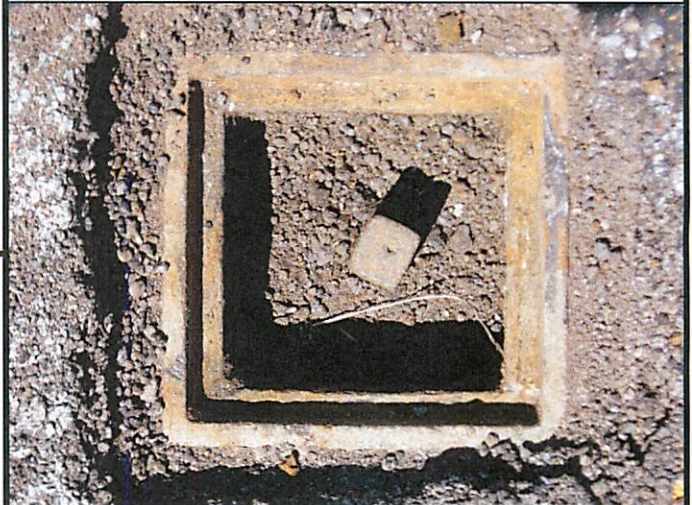

## MISC. INFORMATION

PLACED RISER TO BRING TO SURFACE

