

OTTAWA COUNTY ENGINEERS OFFICE

REFERENCE NO. 23-6-15-D
WEST QUARTER POST SEC. 23
SALEM TWP.
SHEET 1 OF 1.

ROUTE: T-168 BOLSINGER RD.

TOWNSHIP: SALEM

SECTION: 23

T 6 NR 15 E.


PERSONNEL:

M. WITTMAN, P.S.
J. ALLEN
E. KOCH
C. MILLER

NORTHING:

EASTING:

DATUM:

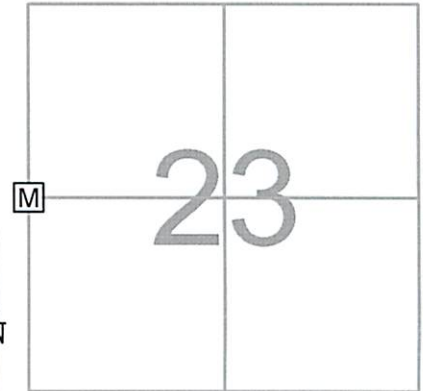


DATE / WEATHER / TEMP:

APRIL 22, 2010
SUNNY - E
52° F

MONUMENT INFORMATION

MONUMENT TYPE: SET 1" SQ. IRON PIN IN
MONUMENT BOX
ON SURFACE - BELOW:
LEFT - CL PAV'T - RIGHT: 0.43'

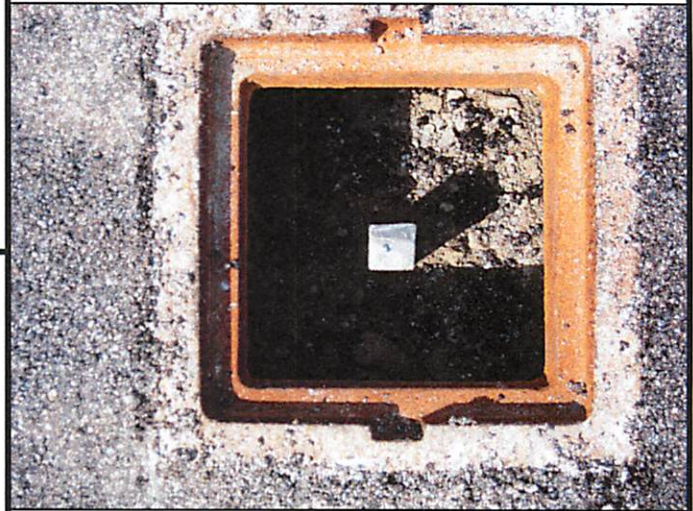

MISC. INFORMATION

FD. RR SPK 0.34' BELOW SURFACE. TIED WITH
X-TIES AND DUG FOR IRON PIN PER COUNTY
RECORDS. DID NOT FIND PIN.

APRIL 22, 2010

SET 1" SQUARE IRON PIN
IN MONUMENT BOX

