

OTTAWA COUNTY ENGINEERS OFFICE

REFERENCE NO. 35-7-15-A
NW CORNER POST SEC. 35
SALEM TWP.
SHEET 1 OF 1.

PERSONNEL:
M. WITTMAN, P.S.
J. ALLEN

DATE / WEATHER / TEMP:
OCTOBER 15-2010
OVERCAST - NW
62° F

ROUTE: C-98 SALEM - CARROLL RD.
@ T-101 LEUTZ RD.

TOWNSHIP: SALEM


SECTION: 35

T 7 N R 15 E.

NORTHING:

EASTING:

DATUM:

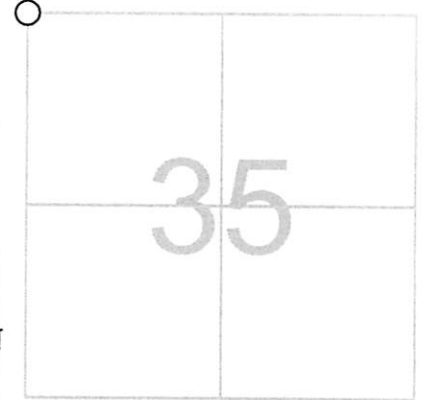


MONUMENT INFORMATION

MONUMENT TYPE: FD. 1/2" Ø IRON PIN IN
CONCRETE
ON SURFACE - BELOW: 0.56'
LEFT - CL PAV'T - RIGHT: 1.30'

MISC. INFORMATION

IRON PIN POSSIBLY SET BY JAMES C. ANDRUS, R.S.
4838 IN JANUARY 1973 (SEE OCE SURVEY FILE
1-12-83). IRON PIN MATCHED P.K. NAIL FOUND ON
SURFACE. IRON PIN ALSO MATCHED DISTANCES
NORTH AND WEST ON SURVEY BY DeWITT IN
SURVEY RECORD BOOK 3 PAGE 345.

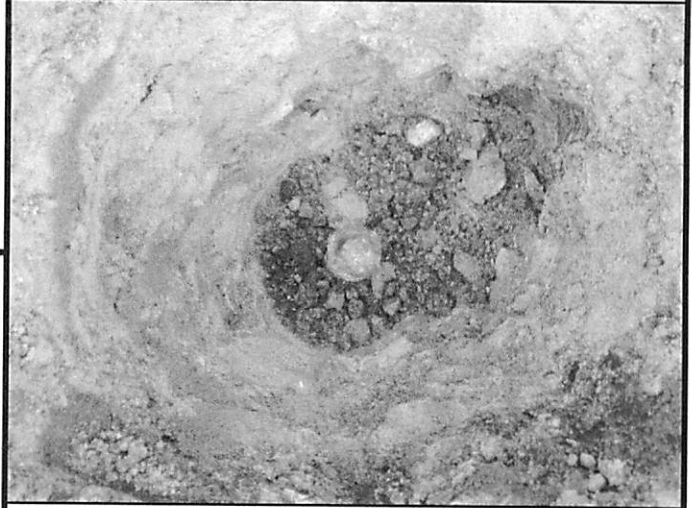

OCTOBER 5, 2010

SET MONUMENT BOX OVER
IRON PIN

